

NEWTON  
L 2017  
7-25-77

MISSISSIPPI  
BOARD OF WATER COMMISSIONERS  
416 North State Street  
13P Jackson, Mississippi 39201

WATER WELL DRILLERS LOG

7-25-77 19 McDonald & Hill Newton  
date well completed firm name county well located

LANDOWNER:

Lommy Graham  
Rt #1 Decatur  
(mailing address)

description of formations encountered

from to

<u>clay + sand</u>	<u>0</u>	<u>10</u>
<u>sand</u>	<u>10</u>	<u>70</u>
<u>sandy shale</u>	<u>70</u>	<u>90</u>
<u>shale</u>	<u>90</u>	<u>127</u>
<u>rock &amp; shells</u>	<u>127</u>	<u>155</u>

WELL LOCATION:

sec 4 T 60N R 12E  
3 miles SE of Decatur  
(distance) (direction) (nearest town)

WELL PURPOSE:

None  
(home, irrigation, municipal, industrial)

<u>green sand + shells</u>	<u>155</u>	<u>165</u>
<u>shale</u>		
<u>Rock + shale + sand</u>	<u>165</u>	<u>200</u>

WELL COMPLETION DATA:

- (1) diameter (inches) 4"
- (2) total depth (feet) 200'
- (3) static water level (feet) 50' below above top of ground.
- (4) casing PVC, 120'  
(material) (depth)  
4" if telescope see back.  
(size)
- (5) screen \_\_\_\_\_  
(length) (depth to top)  
(size) (material)
- (6) pump 1 1590m  
(HP) (yield/gpm)  
E  
(type power)
- (7) electric log \_\_\_\_\_  
(yes or no)  
(organization running log)
- (8) how well bottom plugged open


**RECEIVED**  
AUG 4 1977

MISS. RD. OF WATER COMM

DRILLERS REMARKS:

If well telescopes please sketch and show depths.

GROUND LEVEL

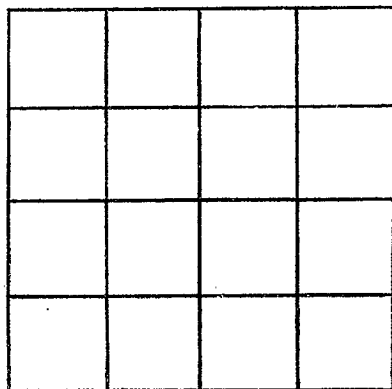

SECTION \_\_\_\_\_

Please indicate well location X.

ADDITIONAL INFORMATION

If more than one screen,  
show locations of each on sketch.