

NEWTON

L 2019

9-12-77

MISSISSIPPI BOARD OF WATER COMMISSIONERS
416 North State Street
13P Jackson, Mississippi 39201

WATER WELL DRILLERS LOG

9-12-77

date well completed

McDonald & Hill

firm name

Newton

county well located

LANDOWNER:

Willis Norman

Rt #1 Newton
(mailing address)

description of formations encountered

clay + sand

from 0

to 16

shale

16 25

sand

2.5 35

shale + sand

35 110

sand + shale

110 155

sand

155 195

sandy shale

195 225

shale

225 260

Rock + shells

260 290

green sand + sandy shale

290 320

WELL LOCATION:

sec. 30 T. 6 N. R. 12 E
S W
2 miles E of Newton
(distance) (direction) (nearest town)

WELL PURPOSE:

home
(home, irrigation, municipal, industrial)

WELL COMPLETION DATA:

- (1) diameter (inches) 4"
- (2) total depth (feet) 320'
- (3) static water level (feet) 40' below top of ground.
- (4) casing PVC 240'
(material) (depth)
4" if telescope see back.
(size)
- (5) screen
(length) (depth to top)
(size) (material)
- (6) pump 1/2 hp 600 gpm
(HP) (yield gpm)
E (type power)
- (7) electric log (yes or no)
(organization running log)
- (8) how well bottom plugged open


DRILLERS REMARKS:

RECEIVED
SEP 19 1977

MISS. BD. OF WATER COM. 44

If well telescopes please sketch and show depths.

GROUND LEVEL

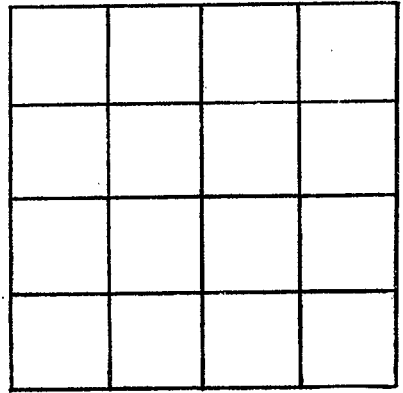

SECTION _____

Please indicate well location X.

ADDITIONAL INFORMATION

If more than one screen, show locations of each on sketch.