

NEWTON  
L 2020  
9-21-77

MISSISSIPPI  
 BOARD OF WATER COMMISSIONERS  
 416 North State Street  
 Jackson, Mississippi 39201

WATER WELL DRILLERS LOG

9-21-77 19 McDonald & Hill Newton  
 date well completed firm name county well located

LANDOWNER:	description of formations encountered	from	to
<u>Willie Grace Lewis</u>	<u>clay</u>	<u>0</u>	<u>12</u>
<u>Rt #1 Newton</u> (mailing address)	<u>shale</u>	<u>12</u>	<u>25</u>
WELL LOCATION:	<u>clay &amp; sand</u>	<u>25</u>	<u>50</u>
sec. <u>9</u> T. <u>6</u> N. R. <u>12</u> E	<u>sand</u>	<u>50</u>	<u>110</u>
<u>3</u> miles <u>SE</u> of <u>Decatur</u> (distance) (direction) (nearest town)	<u>course sand &amp; st. clay</u>	<u>110</u>	<u>170</u>
WELL PURPOSE: <u>home</u> (home, irrigation, municipal, industrial)	<u>sandy shale</u>	<u>170</u>	<u>190</u>
WELL COMPLETION DATA:	<u>shale</u>	<u>190</u>	<u>215</u>
(1) diameter (inches) <u>4"</u>	<u>Rock &amp; shells</u>	<u>215</u>	<u>240</u>
(2) total depth (feet) <u>260'</u>	<u>green sand &amp; sandy shale</u>	<u>240</u>	<u>260</u>
(3) static water level (feet) <u>130'</u> below top of ground.			
(4) casing <u>PVC</u> , <u>203'</u> (material) (depth)			
<u>4"</u> (size) if telescope see back.			
(5) screen _____ (length) (depth to top)			
_____ (size) _____ (material)			
(6) pump <u>3/4</u> <u>6000</u> (HP) (yield gpm)			
_____ (type power)			
(7) electric log _____ (yes or no)			
_____ (organization running log)			
(8) how well bottom plugged <u>open</u>			
DRILLERS REMARKS:			


**RECEIVED**

SEP 26 1977

MISS. BD. OF WATER COMM

If well telescopes please sketch and show depths.

GROUND LEVEL

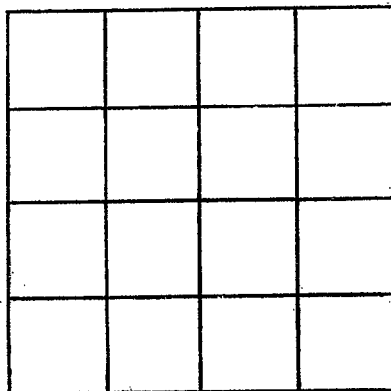

SECTION \_\_\_\_\_

Please indicate well location X.

ADDITIONAL INFORMATION

If more than one screen, show locations of each on sketch.