

Newton  
 L 2021  
 12/21/77

MISSISSIPPI  
 BOARD OF WATER COMMISSIONERS  
 416 North State Street  
 Jackson, Mississippi 39201

WATER WELL DRILLERS LOG

10-21-77 date well completed  
 McDonald + Hill firm name  
 Newton county well located


LANDOWNER:	description of formations encountered	from	to
Thomas Johnson	clay + sand	0	30
RT #1 Newton (mailing address)	sand + shale	30	65
WELL LOCATION:	shale	65	125
sec. 9 T. 6 N. R. 12 E. 4 miles N of Newton	sand	125	150
(distance) (direction) (nearest town)	sandy shale	150	170
WELL PURPOSE: (home, irrigation, municipal, industrial)	shale	170	203
WELL COMPLETION DATA:	Rock + shell	203	225
(1) diameter (inches) 11	Gravel, sand + sandh	225	260
(2) total depth (feet) 260	shale	0	
(3) static water level (feet) 115' below top of ground			
(4) casing PVC 145' (material) (depth)			
11" if telescope see back. (size)			
(5) screen (length) (depth to top)			
(size) (material)			
(6) pump 1/2 HP 190 gpm (HP) (yield gpm)			
(type power)			
(7) electric log (yes or no)			
(organization running log)			
(8) how well bottom plugged from			
DRILLERS-REMARKS:			

RECEIVED  
 DEC 27 1977

MISS. Bd. OF WATER COMMISSIONERS

If well telescopes please sketch and show depths.

GROUND LEVEL

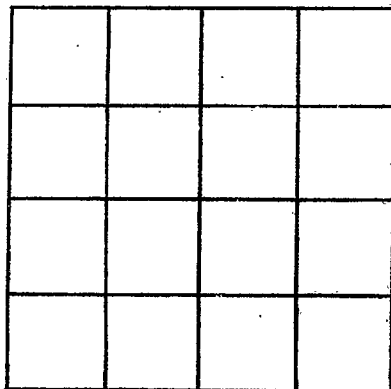

SECTION \_\_\_\_\_

Please indicate well location X.

ADDITIONAL INFORMATION

If more than one screen, show locations of each on sketch.