

MISSISSIPPI DEPARTMENT OF NATURAL RESOURCES

Bureau of Land and Water Resources

Southport Mall

P.O. Box 10631

Jackson, Mississippi 39209

WATER WELL DRILLERS LOG

Newton  
L 2026  
9-5-80

9-5-80  
date well completed

McDonald + Hill  
firm name

Newton  
county well located


LANDOWNER:	description of formations encountered	from	to
Jack Walker Rt 1, Hickory (mailing address)			
WELL LOCATION:	clay + sand	0	20
sec. <u>35</u> T. <u>60</u> N. R. <u>12</u> E.	shale + sand	20	45
<u>1</u> miles <u>W</u> of <u>Hickory</u>	sand	45	100
(distance) (direction) (nearest town)	sandy shale	100	115
WELL PURPOSE: <u>none</u>	shale	115	142
(home, irrigation, municipal, industrial)	rock + shells	142	165
WELL COMPLETION DATA:	green sand	165	175
(1) diameter (inches) <u>4"</u>	rock + shale	175	315
(2) total depth (feet) <u>340'</u>	sand	315	340
(3) static water level (feet) <u>38'</u> below top of ground.			
(4) casing <u>PVC</u> <u>130'</u> (material) (depth)			
<u>4"</u> (size) if telescope see back.			
(5) screen (length) (depth to top)			
(size) (material)			
(6) pump <u>1/2</u> <u>89 gpm</u> (HP) (yield gpm)			
(type power) <u>E</u>			
(7) electric log (yes or no)			
(organization running log)			
(8) how well bottom plugged <u>open</u>			
DRILLERS REMARKS:			

DEPT. OF NATURAL RESOURCES  
BUREAU OF LAND & WATER RESOURCES

SEP 18 1980  
RECEIVED

If well telescopes please  
sketch and show depths.

GROUND LEVEL

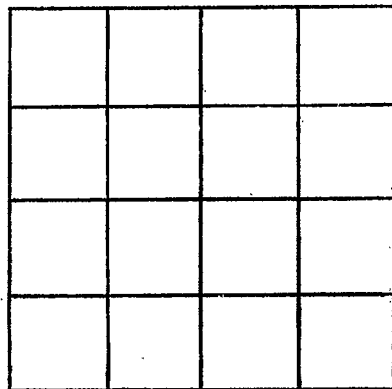

SECTION \_\_\_\_\_

Please indicate well location X.

ADDITIONAL INFORMATION

If more than one screen,  
show locations of each on sketch.