


NEWTON  
 L 208  
 1-10-79

MISSISSIPPI  
 BOARD OF WATER COMMISSIONERS  
 416 North State Street  
 Jackson, Mississippi 39201

WATER WELL DRILLERS LOG

1-10-79 19 McDonald & Well Newton  
 date well completed firm name county well located


LANDOWNER:	description of formations encountered	from	to
Mrs. Audie Thrash	clay + sand	0	15
Rt #1 Hickory (mailing address)	sand	15	70
WELL LOCATION:	sandy shale	70	85
sec. 23 T. 6 N R. 12 E 2 1/2 miles N of Hickory (distance) (direction) (nearest town)	shale	85	105
WELL PURPOSE: home (home, irrigation, municipal, industrial)	Rock & shells	105	130
WELL COMPLETION DATA:	green sand & sandy shale	130	145
(1) diameter (inches) 4"	Rock & shale	145	222
(2) total depth (feet) 300'	sand	222	300
(3) static water level (feet) 60' below top of ground.			
(4) casing PVC 102' (material) (depth) 4" (size) if telescope see back.			
(5) screen (length) (depth to top) (size) (material)			
(6) pump 1/2 HP 1000 (HP) (yield gpm) E (type power)			
(7) electric log (yes or no)			
(organization running log)			
(8) how well bottom plugged open			

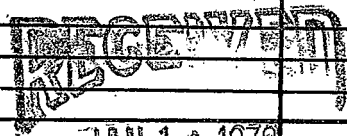

DRILLERS REMARKS:

If well telescopes please sketch and show depths.

GROUND LEVEL

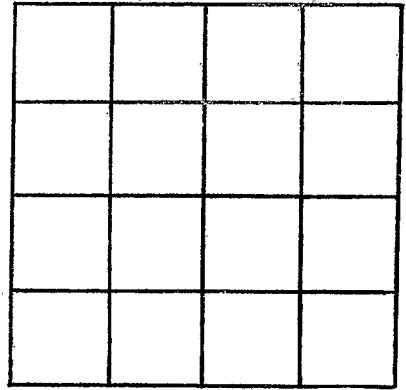

SECTION \_\_\_\_\_

Please indicate well location X.

ADDITIONAL INFORMATION

If more than one screen,  
show locations of each on sketch.