

NEWTON
L 2030
3-28-79

MISSISSIPPI
 BOARD OF WATER COMMISSIONERS
 416 North State Street
 Jackson, Mississippi 39201

WATER WELL DRILLERS LOG

3-19-79 date well completed 19 McDonald's Hill firm name Newton county well located

LANDOWNER:	description of formations encountered	from	to
Sebastian Basset Chemical CO. OW Stuebel Hickory (mailing address)	Clay	0	10
WELL LOCATION:	sand	10	110
sec. <u>12</u> T <u>6</u> N R. <u>12</u> E <u>5</u> miles <u>N</u> of <u>Hickory</u> (distance) (direction) (nearest town)			
WELL PURPOSE: <u>Chemical</u> (home, irrigation, municipal, industrial)			
WELL COMPLETION DATA:			
(1) diameter (inches) <u>2"</u>			
(2) total depth (feet) <u>40'</u>			
(3) static water level (feet) <u>26'</u> below top of ground.			
(4) casing <u>PVC</u> , <u>35'</u> (material) (depth) <u>2"</u> (size) if telescope see back.			
(5) screen <u>5'</u> , <u>35' to 40'</u> (length) (depth to top) <u>2"</u> , <u>PVC</u> (size) (material)			
(6) pump <u>10</u> , <u>1000</u> (HP) (yield gpm) <u>2</u> (type power)			
(7) electric log _____ (yes or no) _____ (organization running log)			
(8) how well bottom plugged <u>variable</u>			
DRILLERS REMARKS:			


Miss. Board of Water Comm.

MAR 27 1979

RECEIVED

If well telescopes please sketch and show depths.

GROUND LEVEL

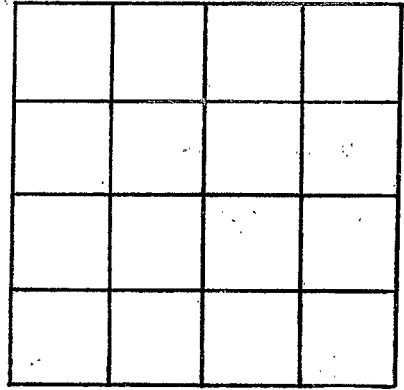

SECTION _____

Please indicate well location X.

ADDITIONAL INFORMATION

If more than one screen,
show locations of each on sketch.