

NEWTON
L 2031
6-21-79

MISSISSIPPI
 BOARD OF WATER COMMISSIONERS
 416 North State Street
 Jackson, Mississippi 39201

WATER WELL DRILLERS LOG

6-21-79 19 McDonald & Hill Newton
 date well completed firm name county well located

LANDOWNER:	description of formations encountered	from	to
Mark Campbell Rt # 2 Deater (mailing address)			
WELL LOCATION: sec. <u>12</u> T <u>6</u> N R <u>20</u> <u>5</u> miles <u>N</u> of <u>McDon</u> (distance) (direction) (nearest town)	clay	0	10
WELL PURPOSE: <u>home</u> (home, irrigation, municipal, industrial)	sand	10	50
WELL COMPLETION DATA: (1) diameter (inches) <u>4"</u>	sandy shale	50	70
(2) total depth (feet) <u>280</u>	shale	70	93
(3) static water level (feet) <u>95'</u> below above top of ground.	Rock & shells	93	117
(4) casing <u>PVC</u> <u>90'</u> (material) (depth) <u>4"</u> If telescope see back. (size)	green sand	117	124
(5) screen _____ (length) (depth to top) (size) (material)	shale & Rock	124	260
(6) pump <u>1/2</u> <u>6 gpm</u> (HP) (yield gpm) <u>F</u> (type power)	sand	260	280
(7) electric log _____ (yes or no) (organization running log)			
(8) how well bottom plugged <u>Open</u>			
DRILLERS REMARKS:			


Miss. Board of Water Comm.

JUN 27 1979

RECEIVED

If well telescopes please sketch and show depths.

GROUND LEVEL

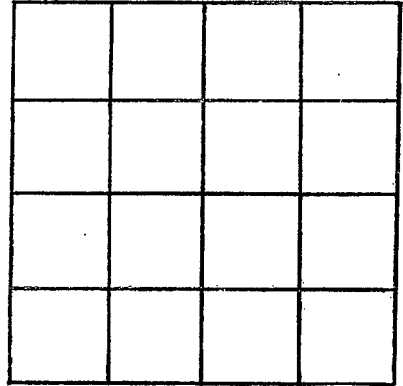

SECTION _____

Please indicate well location X.

ADDITIONAL INFORMATION

If more than one screen,
show locations of each on sketch.