

NEWTON
L 2032
April 5, 1979

MISSISSIPPI
 BOARD OF WATER COMMISSIONERS
 416 North State Street
 Jackson, Mississippi 39201


WATER WELL DRILLERS LOG

date well completed 19 Comans Seal Seal firm name Newton county well located

| LANDOWNER: <u>James W. Rose</u> <u>H-5-199</u> | description of formations encountered | from | to |
|---|---------------------------------------|------|----|
| <u>Newton MS</u> (mailing address) | <u>0-20 Clay</u> | | |
| WELL LOCATION: sec. <u>33</u> T. <u>6</u> N. R. <u>12</u> E. S. W. <u>3</u> miles <u>E</u> of <u>Newton</u> (distance) (direction) (nearest town) | <u>20-55 Clay</u> | | |
| WELL PURPOSE: <u>Home</u> (home, irrigation, municipal, industrial) | | | |
| WELL COMPLETION DATA: | | | |
| (1) diameter (inches) <u>2"</u> | | | |
| (2) total depth (feet) <u>80 FT</u> | | | |
| (3) static water level (feet) <u>65</u> below top of ground. | | | |
| (4) casing <u>PVC</u> , <u>75 FT</u> (material) (depth) | | | |
| _____ If telescope see back. (size) | | | |
| (5) screen <u>5</u> , <u>75</u> (length) (depth to top) | | | |
| _____ (size) _____ (material) | | | |
| (6) pump <u>1</u> , <u>6</u> (HP) (yield gpm) | | | |
| _____ (type power) | | | |
| (7) electric log _____ (yes or no) | | | |
| _____ (organization running log) | | | |
| (8) how well bottom plugged _____ | | | |
| DRILLERS REMARKS: _____ _____ _____ | | | |

If well telescopes please sketch and show depths.

GROUND LEVEL

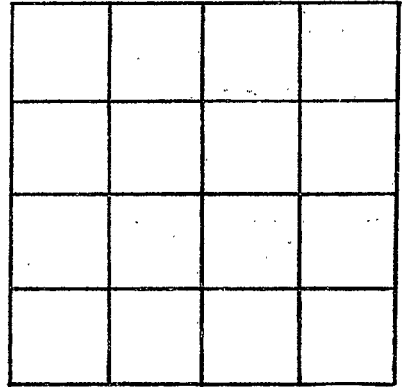

SECTION _____

Please indicate well location X.

ADDITIONAL INFORMATION

If more than one screen, show locations of each on sketch.