

NEWTON
L 2033
8/23/79

**MISSISSIPPI  
BOARD OF WATER COMMISSIONERS**  
416 North State Street  
Jackson, Mississippi 39201  
**WATER WELL DRILLERS LOG**

8 - 23 1979 McDonnell & Well Inc Newton  
date well completed firm name county well located

LANDOWNER: <u>Ray Wallace</u>	description of formations encountered	from	to
<u>RT # 1</u>			
<u>Decatur, Miss</u> (mailing address)	<u>Clay &amp; sand</u>	<u>0</u>	<u>20</u>
	<u>sand 1st brown shale</u>	<u>20</u>	<u>80</u>
WELL LOCATION:	<u>Sandy st sand</u>	<u>80</u>	<u>110</u>
sec. <u>14</u> T. <u>6</u> N. <u>5</u> R. <u>14</u> E. <u>W</u>	<u>Shale</u>	<u>110</u>	<u>145</u>
<u>3</u> miles <u>North</u> of <u>Decatur</u>	<u>st green sand st</u>	<u>145</u>	<u>180</u>
(distance) (direction) (nearest town)	<u>Rock</u>		
WELL PURPOSE: <u>Home</u> (home, irrigation, municipal, industrial)	<u>Shale st Rock</u>	<u>180</u>	<u>196</u>
WELL COMPLETION DATA:	<u>sand</u>	<u>196</u>	<u>200</u>
(1) diameter (inches) <u>4"</u>			
(2) total depth (feet) <u>200'</u>			
(3) static water level (feet) <u>71'</u> below top of ground.			
(4) casing <u>4" PVC</u> <u>128'</u> (material) (depth)			
_____ if telescope see back. (size)			
(5) screen _____ (length) (depth to top)			
(size) _____ (material)			
(6) pump _____ <u>10</u> (HP) (yield gpm)			
(type power)			
(7) electric log _____ (yes or no)			
(organization running log)			
(8) how well bottom plugged <u>Open</u> <u>end</u>			
DRILLERS REMARKS: <u>none</u>			


Miss. Board of Water Comm.

AUG 27 1979

RECEIVED

If well telescopes please sketch and show depths.

GROUND LEVEL

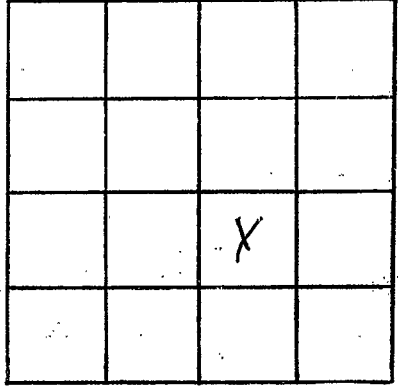

SECTION 14

Please indicate well location X.

ADDITIONAL INFORMATION

If more than one screen, show locations of each on sketch.