

Newton  
L2034  
9-21-79

MISSISSIPPI  
 BOARD OF WATER COMMISSIONERS  
 416 North State Street  
 Jackson, Mississippi 39201

WATER WELL DRILLERS LOG


9-21-79 date well completed      McDonald & Hill firm name      Newton county well located

LANDOWNER:	description of formations encountered	from	to
<u>Georgia Jefferson</u>	<u>Clay</u>	<u>0</u>	<u>12</u>
<u>Rt 2 Decatur</u> (mailing address)	<u>sand &amp; clay</u>	<u>12</u>	<u>80</u>
WELL LOCATION: sec <u>15</u> T <u>6</u> N R <u>12</u> E <u>4</u> miles <u>NW</u> of <u>Hubert</u> (distance) (direction) (nearest town)	<u>shale</u>	<u>80</u>	<u>100</u>
	<u>sand &amp; shale</u>	<u>100</u>	<u>160</u>
WELL PURPOSE: <u>home</u> (home, irrigation, municipal, industrial)	<u>sandy shale</u>	<u>160</u>	<u>170</u>
WELL COMPLETION DATA:	<u>shale</u>	<u>170</u>	<u>205</u>
(1) diameter (inches) <u>4"</u>	<u>rock &amp; shells</u>	<u>205</u>	<u>230</u>
(2) total depth (feet) <u>400'</u>	<u>green sand &amp; sandy shale</u>	<u>230</u>	<u>250</u>
(3) static water level (feet) <u>125'</u> below above top of ground.	<u>rock shale</u>	<u>250</u>	<u>375</u>
(4) casing <u>PVC 200'</u> (material) (depth) <u>4"</u> (size) if telescope see back.	<u>sand</u>	<u>375</u>	<u>400</u>
(5) screen _____ (length) (depth to top) _____ (size) (material)			
(6) pump <u>1/2</u> <u>8000</u> (HP) (yield gpm) <u>F</u> (type power)			
(7) electric log _____ (yes or no) _____ (organization running log)			
(8) how well bottom plugged <u>Open</u>			
DRILLERS REMARKS:			

REC'D  
10-1-79  
DW

If well telescopes please sketch and show depths.

GROUND LEVEL

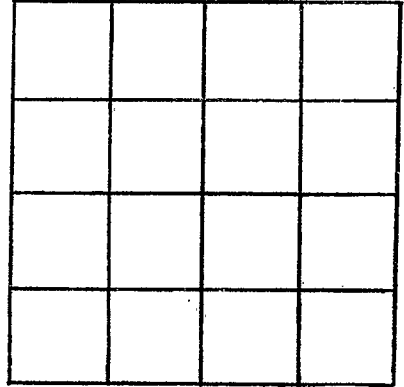

SECTION \_\_\_\_\_

Please indicate well location X.

ADDITIONAL INFORMATION

If more than one screen, show locations of each on sketch.