

Newton
L235
9-26-79

MISSISSIPPI
 BOARD OF WATER COMMISSIONERS
 416 North State Street
 Jackson, Mississippi 39201

WATER WELL DRILLERS LOG


9-26-79 19 McDonald & Hill Newton
 date well completed firm name county well located

LANDOWNER:	description of formations encountered	from	to
<u>Melvin Anderson & J.C. Tanbely</u>			
<u>Rt #1 Hickory</u> (mailing address)	<u>clay</u>	<u>0</u>	<u>10</u>
WELL LOCATION: sec. <u>10</u> T. <u>6</u> N R. <u>2</u> E <u>4</u> miles <u>N</u> of <u>Hickory</u> (distance) (direction) (nearest town)	<u>shale</u>	<u>10</u>	<u>20</u>
WELL PURPOSE: <u>home</u> (home, irrigation, municipal, industrial)	<u>sand & shale</u>	<u>20</u>	<u>30</u>
WELL COMPLETION DATA:	<u>sand & clay</u>	<u>30</u>	<u>40</u>
(1) diameter (inches) <u>2"</u>	<u>shale & sand</u>	<u>40</u>	<u>60</u>
(2) total depth (feet) <u>100'</u>	<u>sand & clay</u>	<u>60</u>	<u>80</u>
(3) static water level (feet) <u>75'</u> below above top of ground.	<u>course sand</u>	<u>80</u>	<u>100</u>
(4) casing <u>PVC 95'</u> (material) (depth) <u>2"</u> if telescope see back. (size)			
(5) screen <u>5'</u> , <u>95 to 100'</u> (length) (depth to top) <u>2"</u> , <u>PVC</u> (size) (material)			
(6) pump <u>1</u> <u>HQDM</u> (HP) (yield gpm) <u>E</u> (type power)			
(7) electric log _____ (yes or no) (organization running log)			
(8) how well bottom plugged <u>used</u>			
DRILLERS REMARKS:			

10-1-79
RM

If well telescopes please sketch and show depths.

GROUND LEVEL

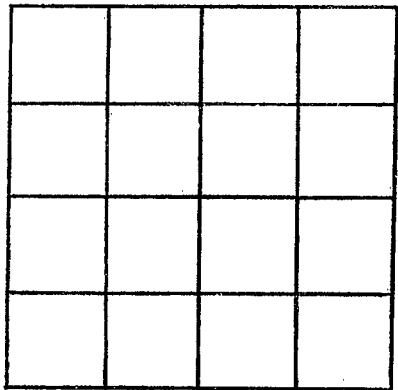

SECTION _____

Please indicate well location X.

ADDITIONAL INFORMATION

A series of horizontal lines for recording additional information.

If more than one screen, show locations of each on sketch.