

Newton
L236
9-26-79

MISSISSIPPI
 BOARD OF WATER COMMISSIONERS
 416 North State Street
 Jackson, Mississippi 39201

WATER WELL DRILLERS LOG


9-26-79 19 McDonald & Well Newton
 date well completed firm name county well located

LANDOWNER:	description of formations encountered	from	to
<u>Gary Thrash</u>	<u>clay + sand</u>	<u>0</u>	<u>25</u>
<u>Rt #1 Hickory</u> (mailing address)	<u>sand</u>	<u>25</u>	<u>80</u>
WELL LOCATION: sec <u>23</u> T <u>6</u> N R <u>15</u> W <u>2</u> miles <u>N</u> of <u>Hickory</u> (distance) (direction) (nearest town)	<u>sandy shale</u>	<u>80</u>	<u>90</u>
	<u>shale</u>	<u>90</u>	<u>110</u>
	<u>Rock + shells</u>	<u>110</u>	<u>140</u>
WELL PURPOSE: <u>home</u> (home, irrigation, municipal, industrial)	<u>green sand + sandy shale</u>	<u>140</u>	<u>150</u>
WELL COMPLETION DATA:			
(1) diameter (inches) <u>4"</u>	<u>Rock + shale</u>	<u>150</u>	<u>280</u>
(2) total depth (feet) <u>300</u>	<u>sand</u>	<u>280</u>	<u>300</u>
(3) static water level (feet) <u>70</u> below top of ground.			
(4) casing <u>PVC 107'</u> (material) (depth) <u>4"</u> if telescope see back. (size)			
(5) screen _____ (length) (depth to top) (size) (material)			
(6) pump <u>1/2 109 gpm</u> (HP) (yield/gpm) <u>F</u> (type power)			
(7) electric log _____ (yes or no) (organization running log)			
(8) how well bottom plugged <u>open</u>			
DRILLERS REMARKS:			

Rec'd
10-1-79
DM

If well telescopes please sketch and show depths.

GROUND LEVEL

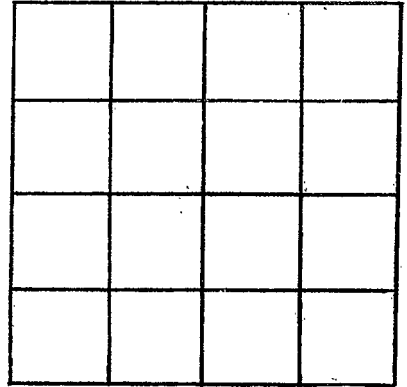

SECTION _____

Please indicate well location X.

ADDITIONAL INFORMATION

If more than one screen, show locations of each on sketch.