

Newton
2
2037
11-5-79

MISSISSIPPI
 BOARD OF WATER COMMISSIONERS
 416 North State Street
 Jackson, Mississippi 39201

WATER WELL DRILLERS LOG

11-3-79 19 McDonalds Well Newton
 date well completed firm name county well located

LANDOWNER:	description of formations encountered	from	to
<u>Bill Brooks</u>	<u>clay + sand</u>	<u>0</u>	<u>25</u>
<u>Rt # 2 Box 130, Newton</u> (mailing address)	<u>shale + sand</u>	<u>25</u>	<u>100</u>
WELL LOCATION: sec. <u>33</u> T. <u>6</u> N R. <u>12</u> E <u>5</u> miles <u>S</u> of <u>Newton</u> (distance) (direction) (nearest town)	<u>sand</u>	<u>100</u>	<u>185</u>
	<u>sandy shale</u>	<u>185</u>	<u>200</u>
	<u>shale</u>	<u>200</u>	<u>233</u>
WELL PURPOSE: <u>home</u> (home, irrigation, municipal, industrial)	<u>rock + shells</u>	<u>233</u>	<u>260</u>
WELL COMPLETION DATA:	<u>greensand + sandy shale</u>	<u>260</u>	<u>280</u>
(1) diameter (inches) <u>4"</u>			
(2) total depth (feet) <u>280'</u>			
(3) static water level (feet) <u>60'</u> below top of ground.			
(4) casing <u>PVC, 220'</u> (material), (depth) <u>4"</u> if telescope see back. (size)			
(5) screen _____ (length) (depth to top) (size) (material)			
(6) pump <u>1/2</u> <u>3000</u> (HP) (yield gpm) <u>2</u> (type power)			
(7) electric log _____ (yes or no) (organization running log)			
(8) how well bottom plugged <u>open</u>			
DRILLERS REMARKS:			


DEPT. OF NATURAL RESOURCES
 BUREAU OF LAND & WATER RESOURCES

NOV 13 1979

RECEIVED

If well telescopes please sketch and show depths.

GROUND LEVEL

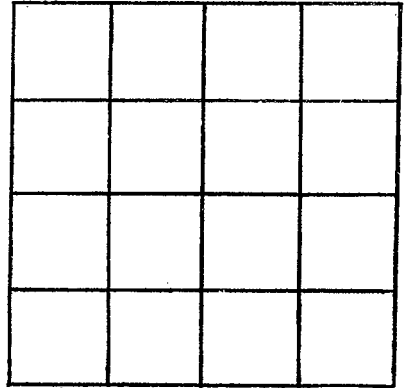

SECTION _____

Please indicate well location X.

ADDITIONAL INFORMATION

If more than one screen, show locations of each on sketch.