

Newton  
L  
2038  
11-29-79

MISSISSIPPI  
BOARD OF WATER COMMISSIONERS  
416 North State Street  
Jackson, Mississippi 39201

WATER WELL DRILLERS LOG

11-29-79 19 McDonald & Hill Newton  
date well completed firm name county well located

LANDOWNER:	description of formations encountered	from	to
<u>Raymond Ledlow</u>	<u>clay</u>	<u>0</u>	<u>8</u>
<u>Rt 11 Newton</u> (mailing address)	<u>sand</u>	<u>8</u>	<u>143</u>
WELL LOCATION: sec. <u>8</u> T. <u>6N</u> R. <u>12E</u> <u>4</u> miles <u>S</u> of <u>Doanville</u> (distance) (direction) (nearest town)	<u>sandy shale</u>	<u>143</u>	<u>165</u>
WELL PURPOSE: <u>home</u> (home, irrigation, municipal, industrial)	<u>shale</u>	<u>165</u>	<u>201</u>
WELL COMPLETION DATA:	<u>Rock &amp; shells</u>	<u>201</u>	<u>235</u>
(1) diameter (inches) <u>4"</u>	<u>green sand &amp; sandy</u>	<u>225</u>	<u>240</u>
(2) total depth (feet) <u>240'</u>	<u>shale</u>		
(3) static water level (feet) <u>98'</u> below top of ground.			
(4) casing <u>PVC 180"</u> (material) (depth) <u>4"</u> if telescope see back. (size)			
(5) screen _____ (length) (depth to top) (size) (material)			
(6) pump <u>1/2</u> <u>69 gpm</u> (HP) (yrd gpm) (type power)			
(7) electric log _____ (yes or no) (organization running log)			
(8) how well bottom plugged <u>open</u>			
DRILLERS REMARKS:			


DEPT. OF NATURAL RESOURCES  
BUREAU OF LAND & WATER RESOURCES

DEC 3 1979

RECEIVED

If well telescopes please sketch and show depths.

GROUND LEVEL

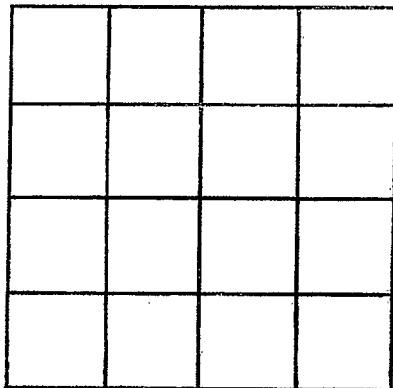

SECTION \_\_\_\_\_

Please indicate well location X.

ADDITIONAL INFORMATION

If more than one screen,  
show locations of each on sketch.