

Newton  
 L 2039  
 12-5-79

MISSISSIPPI  
 BOARD OF WATER COMMISSIONERS  
 416 North State Street  
 Jackson, Mississippi 39201

WATER WELL DRILLERS LOG

12-5-79 19 McDonald & Hill Newton  
 date well completed firm name county well located

LANDOWNER:	description of formations encountered	from	to
<u>Edward &amp; Beatrice Shadmire</u>	<u>Clay</u>	<u>0</u>	<u>12</u>
<u>Hickory</u> (mailing address)	<u>sand + s clay</u>	<u>12</u>	<u>80</u>
<b>WELL LOCATION:</b>			
sec <u>25</u> T <u>6</u> N R <u>12</u> E			
<u>1</u> miles <u>N</u> of <u>Hickory</u>			
(distance) (direction) (nearest town)			
<b>WELL PURPOSE:</b> <u>home</u> (home, irrigation, municipal, industrial)			
<b>WELL COMPLETION DATA:</b>			
(1) diameter (inches) <u>9"</u>			
(2) total depth (feet) <u>80'</u>			
(3) static water level (feet) <u>25'</u> below top of ground.			
(4) casing <u>PVC</u> <u>75'</u> (material) (depth)			
<u>3'</u> (size) if telescope see back.			
(5) screen <u>5'</u> <u>75' to 80'</u> (length) (depth to top)			
<u>9"</u> <u>PVC</u> (size) (material)			
(6) pump <u>1/2</u> <u>6000</u> (HP) (yield gpm)			
<u>E</u> (type power)			
(7) electric log <u>—</u> (yes or no)			
<u>—</u> (organization running log)			
(8) how well bottom plugged <u>value</u>			
<b>DRILLERS REMARKS:</b>			


DEPT. OF NATURAL RESOURCES  
 BUREAU OF LAND & WATER RESOURCES

DEC 11 1979

RECEIVED

If well telescopes please sketch and show depths.

GROUND LEVEL

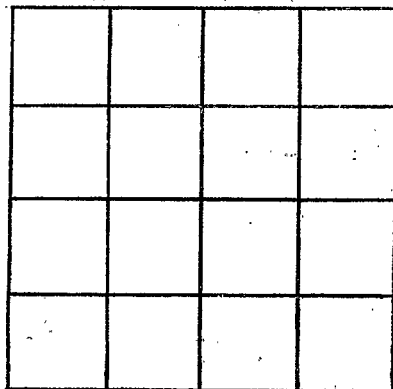

SECTION \_\_\_\_\_

Please indicate well location X.

ADDITIONAL INFORMATION

If more than one screen, show locations of each on sketch.