

Newton
L 244
5-13-80

MISSISSIPPI
BOARD OF WATER COMMISSIONERS
416 North State Street
Jackson, Mississippi 39201

WATER WELL DRILLERS LOG

4-28-80 19 McDonald & Hill Newton
date well completed firm name county well located

LANDOWNER:	description of formations encountered	from	to
J. R. Norman	clay	0	20
Rt # 1 Box 158C, Newton (mailing address)	shale	20	40
WELL LOCATION:	sand	40	50
sec 28 T 6 N R 12 E	shale lignite	50	105
3 miles N of Newton (distance) (direction) (nearest town)	sand	105	195
WELL PURPOSE: none (home, irrigation, municipal, industrial)	sandy shale	185	210
WELL COMPLETION DATA:	shale	210	240
(1) diameter (inches) 4"	Rock & shells	240	270
(2) total depth (feet) 300'	open sand & sandy shale	270	300
(3) static water level (feet) 65' below top of ground.			
(4) casing PVC 230' (material) (depth)			
4" If telescope see back. (size)			
(5) screen (length) (depth to top)			
(size) (material)			
(6) pump 1 100 gpm (HP) (yield gpm)			
(type power)			
(7) electric log (yes or no)			
(organization running log)			
(8) how well bottom plugged open			
DRILLERS REMARKS:			


DEPT. OF NATURAL RESOURCES
BUREAU OF LAND & WATER RESOURCES

MAY 7 - 1980

RECEIVED

If well telescopes please sketch and show depths.

GROUND LEVEL

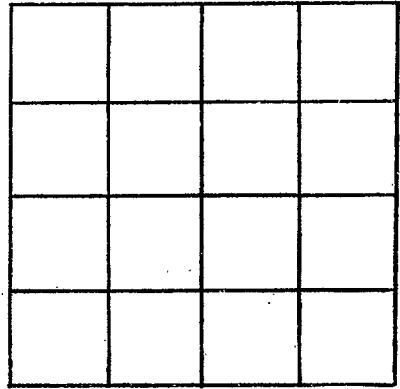

SECTION _____

Please indicate well location X.

ADDITIONAL INFORMATION

If more than one screen, show locations of each on sketch.