

**NEWTON**  
**L 2046**  
**11-20-80**

MISSISSIPPI  
 BOARD OF WATER COMMISSIONERS  
 416 North State Street  
 Jackson, Mississippi 39201

WATER WELL DRILLERS LOG

11-20-80 19 McDonald's Well Newton  
 date well completed firm name county well located

LANDOWNER:	description of formations encountered	from	to
<u>Ms. Jean Curry</u>	<u>clay</u>	<u>0</u>	<u>16</u>
<u>Rt # 9 Box 134-A1, Newton</u> (mailing address)	<u>shale sand &amp; clay</u>	<u>16</u>	<u>35</u>
<b>WELL LOCATION:</b>	<u>shale &amp; sand</u>	<u>35</u>	<u>60</u>
sec. <u>10</u> T <u>6</u> N R <u>12</u> E <u>3 1/2</u> miles <u>SE</u> of <u>Deatons</u> (distance) (direction) (nearest town)	<u>clay &amp; sand</u>	<u>60</u>	<u>80</u>
	<u>course sand</u>	<u>80</u>	<u>115</u>

**WELL PURPOSE:** home  
 (home, irrigation, municipal, industrial)

- WELL COMPLETION DATA:**
- (1) diameter (inches) 2"
  - (2) total depth (feet) 115'
  - (3) static water level (feet) 68' below above top of ground.
  - (4) casing PVC, 110'  
(material) (depth)  
2" if telescope see back.  
(size)
  - (5) screen 5, 110' to 115'  
(length) (depth to top)  
2", PVC  
(size) (material)
  - (6) pump 1, 4 gpm  
(HP) (field gpm)  
L  
(type power)
  - (7) electric log —  
(yes or no)  
—  
(organization running log)
  - (8) how well bottom plugged water


DRILLERS REMARKS:

DEPT. OF NATURAL RESOURCES  
 BUREAU OF LAND & WATER RESOURCES

NOV 25 1980  
 RECEIVED

If well telescopes please sketch and show depths.

GROUND LEVEL

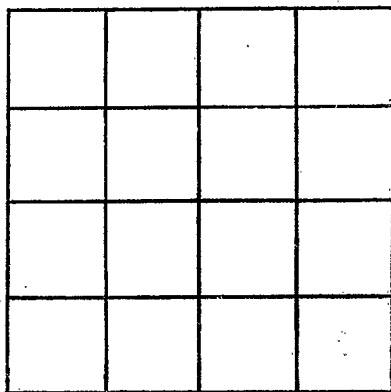

SECTION \_\_\_\_\_

Please indicate well location X.

ADDITIONAL INFORMATION

If more than one screen, show locations of each on sketch.