

NEWTON
L 2347
10-9-80

MISSISSIPPI
BOARD OF WATER COMMISSIONERS
 416 North State Street
 Jackson, Mississippi 39201

WATER WELL DRILLERS LOG

10-9-80 19 McDonald & Hill Newton
 date well completed firm name county well located

LANDOWNER:	description of formations encountered	from	to
(mailing address)			
<u>Michael & Erlina Pickens</u>	<u>clay</u>	<u>0</u>	<u>10</u>
<u>Box # 1 Box 237 Tucker</u>	<u>shale</u>	<u>10</u>	<u>20</u>
<u>3 miles N of Tucker</u>	<u>sand</u>	<u>20</u>	<u>170</u>
<u>sec 21 T 6N R 12E</u>	<u>sandy shale</u>	<u>140</u>	<u>170</u>
<u>3 miles N of Tucker</u>	<u>shale</u>	<u>170</u>	<u>199</u>
<u>WELL PURPOSE: home</u>	<u>rock shells</u>	<u>199</u>	<u>225</u>
<u>(home, irrigation, municipal, industrial)</u>	<u>green sand/sandy shale</u>	<u>225</u>	<u>247</u>
WELL COMPLETION DATA:			
(1) diameter (inches) <u>4"</u>			
(2) total depth (feet) <u>240'</u>			
(3) static water level (feet) <u>105'</u> below top of ground.			
(4) casing <u>PVC, 190'</u> (material) (depth)			
<u>4"</u> if telescope see back. (size)			
(5) screen _____ (length) (depth to top)			
(size) (material)			
(6) pump <u>1/2</u> <u>6000</u> (HP) (yield gpm)			
(type power)			
(7) electric log _____ (yes or no)			
(organization running log)			
(8) how well bottom plugged <u>Open</u>			
DRILLERS REMARKS:			


DEPT. OF NATURAL RESOURCES
 BUREAU OF LAND & WATER RESOURCES

OCT 14 1980

RECEIVED

If well telescopes please sketch and show depths.

GROUND LEVEL

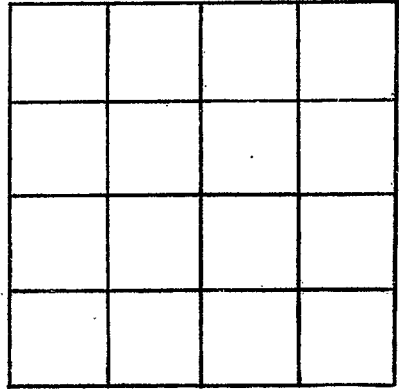

SECTION _____

Please indicate well location X.

ADDITIONAL INFORMATION

If more than one screen, show locations of each on sketch.