

Newton
L 298
3-18-81
3-18-81

MISSISSIPPI
 BOARD OF WATER COMMISSIONERS
 416 North State Street
 Jackson, Mississippi 39201



WATER WELL DRILLERS LOG

McDonald & Hill

Newton

date well completed

firm name

county well located

LANDOWNER:
Jack McKee
RT # 2, Box 70, Decatur
 (mailing address)

description of formations encountered	from	to
Clay	0	10
sand	10	45
sandy shale	45	72
shale	72	100
Rock shell	100	120
green sand	120	127
shale & rock	127	180
sand	180	185
shale & rock	185	250
sandy shale	250	270
fine sand	270	300

WELL LOCATION:
 sec. 1 T. 6 N. R. 12 E.
5 miles N of Hickory
 (distance) (direction) (nearest town)

WELL PURPOSE: Home
 (home, irrigation, municipal, industrial)

WELL COMPLETION DATA:

(1) diameter (inches) 4"

(2) total depth (feet) 300

(3) static water level (feet) 100' below top of ground.

(4) casing PVC, 95'
 (material) (depth)
4" if telescope see back.
 (size)

(5) screen _____
 (length) (depth to top)

 (size) (material)

(6) pump 1/2 60 gpm
 (HP) (rated gpm)
F
 (type power)

(7) electric log _____
 (yes or no)

 (organization running log)

(8) how well bottom plugged Open

DEPT. OF NATURAL RESOURCES
 BUREAU OF LAND & WATER RESOURCES


MAR 25 1981

RECEIVED

DRILLERS REMARKS:

If well telescopes please sketch and show depths.

GROUND LEVEL

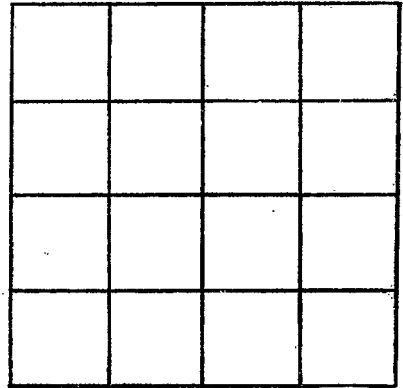

SECTION _____

Please indicate well location X.

ADDITIONAL INFORMATION

If more than one screen, show locations of each on sketch.