

MISSISSIPPI DEPARTMENT OF NATURAL RESOURCES

Bureau of Land and Water Resources

Southport Mall

P.O. Box 10631

Jackson, Mississippi 39209

WATER WELL DRILLERS LOG

3

Newton  
L2050  
7-21-81

7-21-81, 19 McDonald & Hill Newton  
date well completed firm name county well located

LANDOWNER:  
Vera Blackwell  
Rt # 1 Newton  
(mailing address)

WELL LOCATION:  
sec 29 T 6 N R 12 E  
3 miles S E of Newton  
(distance) (direction) (nearest town)

WELL PURPOSE: home  
(home, irrigation, municipal, industrial)

- WELL COMPLETION DATA:
- (1) diameter (inches) 4 1/2
  - (2) total depth (feet) 260'
  - (3) static water level (feet) 60' below top of ground.
  - (4) casing PVC 180' (material) (depth)  
4" (size) if telescope see back.
  - (5) screen (length) (depth to top)  
(size) (material)
  - (6) pump 1/2 8gpm (HP) (yield gpm)  
E (type power)
  - (7) electric log (yes or no)  
(organization running log)
  - (8) how well bottom plugged open

| description of formations encountered | from | to  |
|---------------------------------------|------|-----|
| clay                                  | 0    | 10  |
| sand                                  | 10   | 20  |
| shale                                 | 20   | 50  |
| shale & sand                          | 50   | 80  |
| sand & shale                          | 80   | 100 |
| sand                                  | 100  | 143 |
| sandy shale                           | 143  | 170 |
| shale                                 | 170  | 197 |
| Rock & shells                         | 197  | 222 |
| green sand & sandy shale              | 222  | 240 |
| Rock shale & sand                     | 240  | 260 |

DEPT. OF NATURAL RESOURCES  
BUREAU OF LAND & WATER RESOURCES


JUL 27 1981

RECEIVED

DRILLERS REMARKS:

If well telescopes please sketch and show depths.

GROUND LEVEL

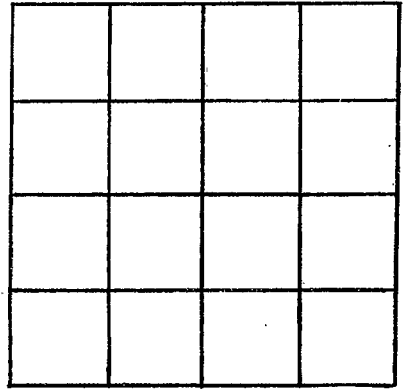

SECTION \_\_\_\_\_

Please indicate well location X.

ADDITIONAL INFORMATION

If more than one screen,  
show locations of each on sketch.