

MISSISSIPPI DEPARTMENT OF NATURAL RESOURCES

Bureau of Land and Water Resources

Southport Mall

P.O. Box 10631

Jackson, Mississippi 39209

WATER WELL DRILLERS LOG

Newton  
L2051  
7-17-81

7-17-81  
date well completed

McDonald & Hill  
firm name

Newton  
county well located

LANDOWNER:  
Arthur Adams  
RT # 2 Box 150C, Newton  
(mailing address)

description of formations encountered	from	to
Clay	0	22
sand	22	140
sandy shale	140	170
shale	170	199
Rock & shale	199	230
greens sand	230	240
shale & rock & sand	240	260

WELL LOCATION:  
sec 28 T 6 N R 12 E  
3 miles S E of Newton  
(distance) (direction) (nearest town)

WELL PURPOSE: home  
(home, irrigation, municipal, industrial)

- WELL COMPLETION DATA:
- (1) diameter (inches) 4"
  - (2) total depth (feet) 260'
  - (3) static water level (feet) 60' below above top of ground.
  - (4) casing PVC 180',  
(material) (depth)  
4" If telescope see back.  
(size)
  - (5) screen — (length) — (depth to top)  
(size) (material)
  - (6) pump 12 89.0M  
(HP) (yield gpm)  
F  
(type power)
  - (7) electric log — (yes or no)  
(organization running log)
  - (8) how well bottom plugged Open

DEPT. OF NATURAL RESOURCES  
BUREAU OF LAND & WATER RESOURCES


JUL 27 1981

RECEIVED

DRILLERS REMARKS:  
Open

If well telescopes please sketch and show depths.

GROUND LEVEL

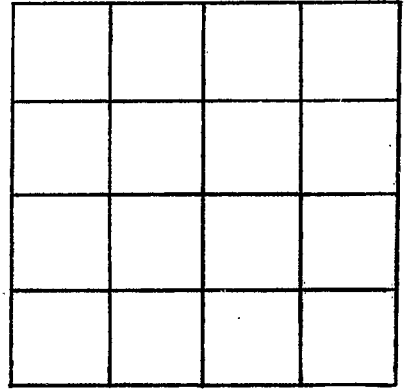

SECTION \_\_\_\_\_

Please indicate well location X.

ADDITIONAL INFORMATION

If more than one screen, show locations of each on sketch.