

MISSISSIPPI DEPARTMENT OF NATURAL RESOURCES

Bureau of Land and Water Resources

Southport Mall

P.O. Box 10631

Jackson, Mississippi 39209

WATER WELL DRILLERS LOG

**NEWTON**  
**L 2052**  
**10-22-81**

10-22-81  
 date well completed

McDonald & Well  
 firm name

Newton  
 county well located

**LANDOWNER:**  
 Newton Co. Country Club  
 Newton  
 (mailing address)

**WELL LOCATION:**  
 sec. 20 T. 6 N R. 12 E  
2 miles (distance) of Newton (nearest town)  
 (direction)

**WELL PURPOSE:** Home  
 (home, irrigation, municipal, industrial)

- WELL COMPLETION DATA:**
- (1) diameter (inches) 4 X 2
  - (2) total depth (feet) 242
  - (3) static water level (feet) 160 below top of ground.
  - (4) casing PVC 200' (material), (depth)  
4" (size) if telescope see back. 42' 2" PVC
  - (5) screen 10 (length), 232 to 242 (depth to top)  
2" (size), PVC (material)
  - (6) pump 1 (HP), 890 M (yield gpm)  
E (type power)
  - (7) electric log — (yes or no)  
 (organization running log)
  - (8) how well bottom plugged cap

description of formations encountered	from	to
clay & sand	0	25
shale	25	70
shale & sand	70	110
sand	110	150
sandy	150	170
shale	170	205
Rock & shell	205	232
green sand & sand shale	232	242

DEPT. OF NATURAL RESOURCES  
 BUREAU OF LAND & WATER RESOURCES


OCT 26 1981

RECEIVED

DRILLERS REMARKS: Rubber seal set at 160'

If well telescopes please sketch and show depths.

GROUND LEVEL

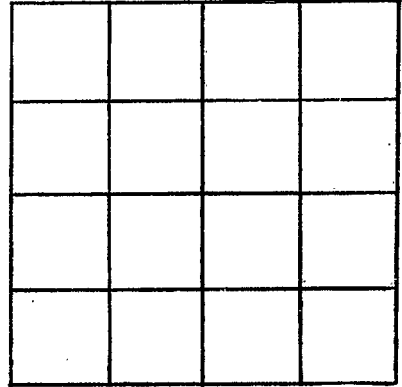

SECTION \_\_\_\_\_

Please indicate well location X.

ADDITIONAL INFORMATION

If more than one screen, show locations of each on sketch.