

MISSISSIPPI DEPARTMENT OF NATURAL RESOURCES

Bureau of Land and Water Resources

Southport Mall

P.O. Box 10631

Jackson, Mississippi 39209

WATER WELL DRILLERS LOG

Newton
L 2054
11-16-81

11-16-81 19 McDonald & Hill Newton
 date well completed firm name county well located

LANDOWNER:	description of formations encountered	from	to
<u>Johnny H. Ald</u>	<u>clay & sand</u>	<u>0</u>	<u>70</u>
<u>Pt 1, Box 139A, Newton</u> (mailing address)	<u>course sand</u>	<u>70</u>	<u>92</u>

WELL LOCATION:
 sec. 15 T. 6 N. R. 12 E.
6 miles N of Trichon
 (distance) (direction) (nearest town)

WELL PURPOSE: none
 (home, irrigation, municipal, industrial)

WELL COMPLETION DATA:

(1) diameter (inches) 2"

(2) total depth (feet) 92'

(3) static water level (feet) 63' below top of ground.

(4) casing PVC, 87'
 (material) (depth)
2" if telescope see back.
 (size)

(5) screen 5, 87' to 92'
 (length) (depth to top)
2" PVC
 (size) (material)

(6) pump 1 4900W
 (HP) (yield gpm)
K
 (type power)

(7) electric log —
 (yes or no)
 (organization running log)

(8) how well bottom plugged value

DRILLERS REMARKS:


DEPT. OF NATURAL RESOURCES
 BUREAU OF LAND & WATER RESOURCES

NOV 23 1981

RECEIVED

If well telescopes please sketch and show depths.

GROUND LEVEL

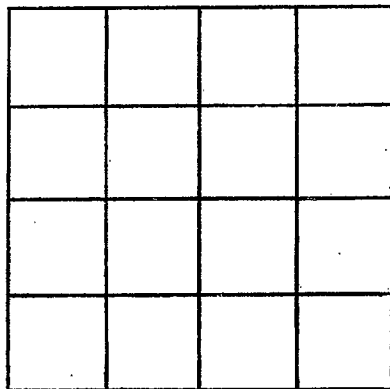

SECTION _____

Please indicate well location X.

ADDITIONAL INFORMATION

If more than one screen, show locations of each on sketch.