

Newton  
L  
2055

MISSISSIPPI  
BOARD OF WATER COMMISSIONERS  
416 North State Street  
Jackson, Mississippi 39201

WATER WELL DRILLERS LOG

2 1982 The Donald Bell  
date well completed firm name Newton  
county well located

LANDOWNER: John Magheall  
Hickory, Miss

(mailing address)

WELL LOCATION:

sec. 20 T. 6 N R. 17 E  
3 1/2 miles East of Newton  
(distance) (direction) (nearest town)

WELL PURPOSE: none  
(home, irrigation, municipal, industrial)

WELL COMPLETION DATA:

- (1) diameter (inches) 4
- (2) total depth (feet) 256
- (3) static water level (feet) 83 below above top of ground.
- (4) casing 4" PVC 200'  
(material) (depth)
- 2" 45' if telescope see back.  
(size)
- (5) screen 20'  
(length) (depth to top)
- 2" PVC 20'  
(size) (material)
- (6) pump 1/4 10  
(HP) (yield gpm)

(type power)

(7) electric log (yes or no)

(organization running log)

(8) how well bottom plugged back  
pressure valve

DRILLERS REMARKS:

description of formations encountered

from to

Clay & sand	0	30
Shale st lignite	30	100
st coarse sand	100	165
shale, sandy st	155	178
shale	178	214
Sandy st Rock	214	240
green sand	240	256


DEPT. OF NATURAL RESOURCES  
BUREAU OF LAND & WATER RESOURCES

FEB 16 1992

RECEIVED

If well telescopes please sketch and show depths.

GROUND LEVEL

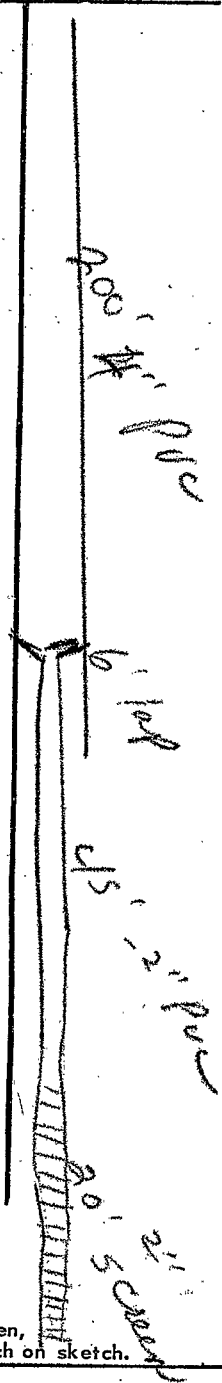

			X

SECTION 20

Please indicate well location X.

ADDITIONAL INFORMATION

A series of horizontal lines for recording additional information.

If more than one screen, show locations of each on sketch.