

MISSISSIPPI DEPARTMENT OF NATURAL RESOURCES
Bureau of Land and Water Resources
 Southport Mall
 P.O. Box 10631
 Jackson, Mississippi 39209
WATER WELL DRILLERS LOG

Newton
2856

6-10-82 19 McDonald Hill Newton
 date well completed firm name county well located

LANDOWNER:	description of formations encountered	from	to
<u>Ricky Strait</u> <u>Rt #1 Hickory</u> (mailing address)			
WELL LOCATION: sec <u>27</u> T <u>6</u> N R <u>12</u> E <u>9</u> miles <u>SW</u> of <u>Hickory</u> (distance) (direction) (nearest town)	<u>sand st clay</u>	<u>60</u>	<u>105</u>
WELL PURPOSE: <u>home</u> (home, irrigation, municipal, industrial)	<u>sandy shale</u>	<u>105</u>	<u>120</u>
WELL COMPLETION DATA:	<u>shale</u>	<u>120</u>	<u>150</u>
(1) diameter (inches) <u>4"</u>	<u>Rock, shells</u>	<u>150</u>	<u>180</u>
(2) total depth (feet) <u>340'</u>	<u>green sand</u>	<u>180</u>	<u>188</u>
(3) static water level (feet) <u>40'</u> below top of ground.	<u>Rock & shale</u>	<u>188</u>	<u>320</u>
(4) casing <u>PVC</u> <u>140'</u> (material) (depth)	<u>shale st sand</u>	<u>320</u>	<u>330</u>
<u>4"</u> If telescope see back. (size)	<u>course sand</u>	<u>330</u>	<u>340</u>
(5) screen _____ (length) (depth to top)			
(size) _____ (material)			
(6) pump <u>1/2</u> <u>80-DM</u> (HP) (yield gpm)			
(type power) _____			
(7) electric log _____ (yes or no)			
(organization running log) _____			
(8) how well bottom plugged <u>open</u>			

DEPT. OF NATURAL RESOURCES
 BUREAU OF LAND & WATER RESOURCES


JUN 15 1982

RECEIVED

DRILLERS REMARKS:

If well telescopes please
sketch and show depths.

GROUND LEVEL

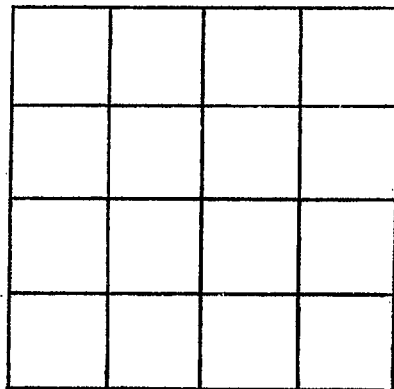

SECTION _____

Please indicate well location X.

ADDITIONAL INFORMATION

If more than one screen,
show locations of each on sketch.