

MISSISSIPPI DEPARTMENT OF NATURAL RESOURCES

Bureau of Land and Water Resources

Southport Mall

P.O. Box 10631

Jackson, Mississippi 39209

WATER WELL DRILLERS LOG

Newton
L
2057

7-29-82
date well completed

McDonald's Well
firm name

Newton
county well located

LANDOWNER:
Ronnie Hunt
Rt # 1 Hickory
(mailing address)

description of formations encountered

	from	to
<u>clay + sand</u>	<u>0</u>	<u>42</u>
<u>shale</u>	<u>42</u>	<u>60</u>

WELL LOCATION:
sec. 15 T. 6 N. R. 12 E.
S miles NW of Hickory
(distance) (direction) (nearest town)

Rock & sand	<u>60</u>	<u>70</u>
<u>sandy shale</u>	<u>70</u>	<u>85</u>
<u>shale</u>	<u>85</u>	<u>120</u>

WELL PURPOSE: home
(home, irrigation, municipal, industrial)

<u>Rock & shells</u>	<u>120</u>	<u>150</u>
--------------------------	------------	------------

WELL COMPLETION DATA:

(1) diameter (inches) 4"

(2) total depth (feet) 300'

(3) static water level (feet) 75' below top of ground.

(4) casing PVC, 110'
(material) (depth)
4"
(size) If telescope see back.

(5) screen _____
(length) (depth to top)
(size) (material)

(6) pump 34 890m
(HP) (yield gpm)
F
(type power)

(7) electric log _____
(yes or no)
(organization running log)

(8) how well bottom plugged Open

<u>green sand</u>	<u>150</u>	<u>165</u>
<u>Rock & shale</u>	<u>165</u>	<u>280</u>
<u>sandy shale</u>	<u>280</u>	<u>290</u>
<u>circle sand</u>	<u>290</u>	<u>300</u>

DRILLERS REMARKS:


DEPT. OF NATURAL RESOURCES
BUREAU OF LAND & WATER RESOURCES

AUG - 2 1982

RECEIVED

If well telescopes please sketch and show depths.

GROUND LEVEL

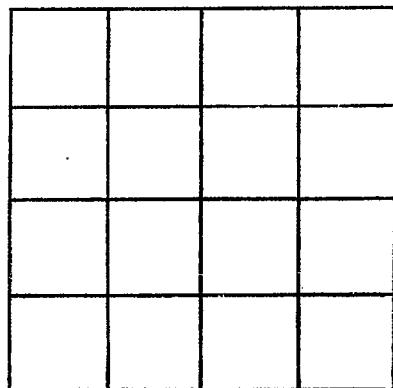

SECTION _____

Please indicate well location X.

ADDITIONAL INFORMATION

If more than one screen,
show locations of each on sketch.