

MISSISSIPPI DEPARTMENT OF NATURAL RESOURCES

Bureau of Land and Water Resources

Southport Mall

P.O. Box 10631

Jackson, Mississippi 39209

WATER WELL DRILLERS LOG

Newton
L
2059

7-2-82 19 McDonald's Well Newton
 date well completed firm name county well located

LANDOWNER:	description of formations encountered	from	to
<u>Willie Mae Wash</u>			
<u>Rt # 2 Newton</u> (mailing address)	<u>shale</u>	<u>10</u>	<u>55</u>
WELL LOCATION:	<u>sand & shale</u>	<u>55</u>	<u>160</u>
sec. <u>19</u> T. <u>6</u> N R. <u>2</u> E	<u>sandy shale</u>	<u>160</u>	<u>185</u>
<u>3</u> miles <u>S</u> of <u>Newton</u>	<u>shale</u>	<u>185</u>	<u>225</u>
(distance) (direction) (nearest town)	<u>Rock & shells</u>	<u>225</u>	<u>255</u>
WELL PURPOSE: <u>Home</u> (home, irrigation, municipal, industrial)	<u>green sand</u>	<u>255</u>	<u>280</u>
WELL COMPLETION DATA:			
(1) diameter (inches) <u>4"</u>			
(2) total depth (feet) <u>280</u>			
(3) static water level (feet) <u>45'</u> below above top of ground.			
(4) casing <u>PVC 200'</u> (material) (depth)			
<u>2"</u> (size) if telescope see back.			
(5) screen <u>—</u> <u>—</u> (length) (depth to top)			
(size) (material)			
(6) pump <u>1/2</u> <u>89 gpm</u> (HP) (yield/gpm)			
(type power) <u>E</u>			
(7) electric log <u>—</u> (yes or no)			
(organization running log)			
(8) how well bottom plugged <u>dam</u>			
DRILLERS REMARKS:			


DEPT. OF NATURAL RESOURCES
 BUREAU OF LAND & WATER RESOURCES

JUL 12 1982

RECEIVED

If well telescopes please sketch and show depths.

GROUND LEVEL

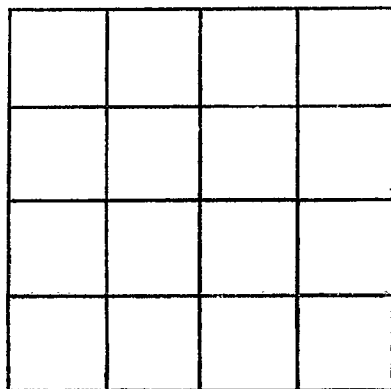

SECTION _____

Please indicate well location X.

ADDITIONAL INFORMATION

If more than one screen,
show locations of each on sketch.