

Newton
L
260

MISSISSIPPI DEPARTMENT OF NATURAL RESOURCES
 Bureau of Land and Water Resources
 Southport Mall
 P.O. Box 10631
 Jackson, Mississippi 39209
WATER WELL DRILLERS LOG

7-6-82 19 McDonald's Well Newton
 date well completed firm name county well located

LANDOWNER:
J.J. Rouch
~~Rt 2~~ 2 Newton
 (mailing address)

WELL LOCATION:
 sec. 18 T 6 N R 12 E
4 miles N.E. of Newton
 (distance) (direction) (nearest town)

WELL PURPOSE: home
 (home, irrigation, municipal, industrial)

WELL COMPLETION DATA:

- (1) diameter (inches) 4"
- (2) total depth (feet) 300'
- (3) static water level (feet) 80' below top of ground.
- (4) casing PVC, 200'
 (material) (depth)
4" if telescope see back.
 (size)
- (5) screen _____
 (length) (depth to top)
 (size) (material)
- (6) pump 1/2 89 PWC
 (HP) (yield gpm)
F
 (type power)
- (7) electric log _____
 (yes or no)
 (organization running log)
- (8) how well bottom plugged Open

description of formations encountered	from	to
clay	0	18
shale	18	40
shale & s.t. sand	40	60
shale	60	100
shale & sand	100	125
sand	125	175
sandy shale	175	195
shale	195	240
Rock & shells	240	265
green sand & sandy shale	265	285
Rock & shale	285	300

DEPT. OF NATURAL RESOURCES
 BUREAU OF LAND & WATER RESOURCES


JUL 12 1982

RECEIVED

DRILLERS REMARKS:

If well telescopes please sketch and show depths.

GROUND LEVEL

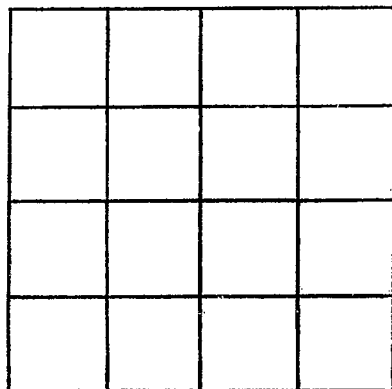

SECTION _____

Please indicate well location X.

ADDITIONAL INFORMATION

If more than one screen,
show locations of each on sketch.