

MISSISSIPPI DEPARTMENT OF NATURAL RESOURCES

Bureau of Land and Water Resources

Southport Mall

P.O. Box 10631

Jackson, Mississippi 39209

WATER WELL DRILLERS LOG

Newton
L
2061

10-21-82 19 McDonald & Hill Newton
date well completed firm name county well located

LANDOWNER:	description of formations encountered	from	to
<u>Arnie Thompson</u>	<u>Clay</u>	<u>0</u>	<u>15</u>
<u>McKow</u> (mailing address)	<u>sand</u>	<u>15</u>	<u>125</u>
WELL LOCATION:	<u>sandy shale</u>	<u>125</u>	<u>140</u>
sec. <u>10</u> T- <u>6</u> N R- <u>12</u> E <u>4</u> miles <u>SE</u> of <u>Decatur</u> (distance) (direction) (nearest town)	<u>shale</u>	<u>140</u>	<u>166</u>
WELL PURPOSE: <u>home</u> (home, irrigation, municipal, industrial)	<u>rock & shells</u>	<u>166</u>	<u>200</u>
WELL COMPLETION DATA:	<u>green sand & sand</u>	<u>200</u>	<u>220</u>
(1) diameter (inches) <u>4"</u>	<u>chena</u>		
(2) total depth (feet) <u>220'</u>			
(3) static water level (feet) <u>100'</u> below top of ground.			
(4) casing <u>PVC</u> , <u>1100'</u> (material) (depth) <u>4"</u> if telescope see back. (size)			
(5) screen _____ (length) (depth to top) (size) (material)			
(6) pump <u>1/2</u> <u>89 gpm</u> (HP) (yield gpm) <u>R</u> (type power)			
(7) electric log _____ (yes or no) (organization running log)			
(8) how well bottom plugged <u>open</u>			
DRILLERS REMARKS:			


DEPT. OF NATURAL RESOURCES
BUREAU OF LAND & WATER RESOURCES

OCT 26 1982

RECEIVED

If well telescopes please sketch and show depths.

GROUND LEVEL

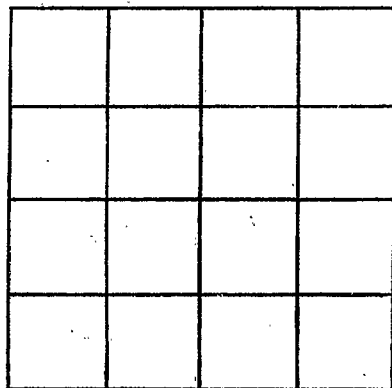

SECTION _____

Please indicate well location X.

ADDITIONAL INFORMATION

If more than one screen,
show locations of each on sketch.