

MISSISSIPPI DEPARTMENT OF NATURAL RESOURCES

Bureau of Land and Water Resources

Southport Mall

P.O. Box 10631

Jackson, Mississippi 39209

WATER WELL DRILLERS LOG

Newton  
L  
2062

05

6/16/83

6-7-83 McDONALD-HILL NEWTON  
 date well completed firm name county well located

LANDOWNER:  
WALTER JOHNSON  
R#2 DECATUR  
 (mailing address)

description of formations encountered	from	to
CLAY	0	6
SAND	6	63
SOFT SHALE	63	70
SHALE	70	100
ROCK	100	105
ROCK STR SAND	105	130
SAND STR ROCK	130	180

WELL LOCATION:  
 sec. 4 T. 6 S. R. 12 W.  
3 miles SOUTH of DECATUR  
 (distance) (direction) (nearest town)

WELL PURPOSE: HOME  
 (home, irrigation, municipal, industrial)

WELL COMPLETION DATA:

(1) diameter (inches) 4 1/2

(2) total depth (feet) 180

(3) static water level (feet) 55 below top of ground.

(4) casing PVC, 95'  
 (material) (depth)  
 (size) If telescope see back.

(5) screen 4  
 (length) (depth to top)  
 (size) (material)

(6) pump 1/2 7  
 (HP) (yield gpm)  
 (type power)

(7) electric log \_\_\_\_\_  
 (yes or no)  
 (organization running log)

(8) how well bottom plugged OPEN

DEPT. OF NATURAL RESOURCES  
 BUREAU OF LAND & WATER RESOURCES


JUN 13 1983

RECEIVED

DRILLERS REMARKS:

If well telescopes please sketch and show depths.

GROUND LEVEL

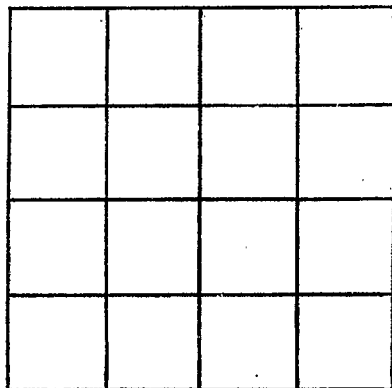

SECTION \_\_\_\_\_

Please indicate well location X.

ADDITIONAL INFORMATION

If more than one screen,  
show locations of each on sketch.