

MISSISSIPPI DEPARTMENT OF NATURAL RESOURCES

Bureau of Land and Water Resources

Southport Mall

P.O. Box 10631

Jackson, Mississippi 39209

WATER WELL DRILLERS LOG

Newton
L
2063

3-16-83
 date well completed

McDonald & Hill
 firm name

Newton
 county well located

LANDOWNER:	description of formations encountered	from	to
<u>Charles F. Moduin</u>	<u>clay & sand</u>	<u>0</u>	<u>16</u>
<u>PO Box 27 Newton</u> (mailing address)	<u>shale</u>	<u>16</u>	<u>40</u>
WELL LOCATION:	<u>sand & shale</u>	<u>40</u>	<u>120</u>
sec. <u>6</u> T <u>6</u> N R <u>12</u> E <u>3</u> miles <u>5</u> S of <u>Deerfield</u> (distance) (direction) (nearest town)	<u>sandy shale</u>	<u>120</u>	<u>150</u>
WELL PURPOSE: <u>home</u> (home, irrigation, municipal, industrial)	<u>shale</u>	<u>150</u>	<u>190</u>
WELL COMPLETION DATA:	<u>Rock & shells</u>	<u>190</u>	<u>210</u>
(1) diameter (inches) <u>4"</u>	<u>green sand</u>	<u>210</u>	<u>230</u>
(2) total depth (feet) <u>240'</u>	<u>white sand & sandy shale</u>	<u>230</u>	<u>240</u>
(3) static water level (feet) <u>100'</u> below above top of ground.			
(4) casing <u>PVC</u> , <u>180'</u> (material) (depth) <u>4"</u> If telescope see back. (size)			
(5) screen _____ (length) (depth to top) (size) (material)			
(6) pump <u>3/4</u> <u>890 m</u> (HP) (yield gpm) <u>F</u> (type power)			
(7) electric log _____ (yes or no) (organization running log)			
(8) how well bottom plugged <u>open</u>			

DEPT. OF NATURAL RESOURCES
 BUREAU OF LAND & WATER RESOURCES


MAR 21 1983

RECEIVED

DRILLERS REMARKS:

If well telescopes please sketch and show depths.

GROUND LEVEL

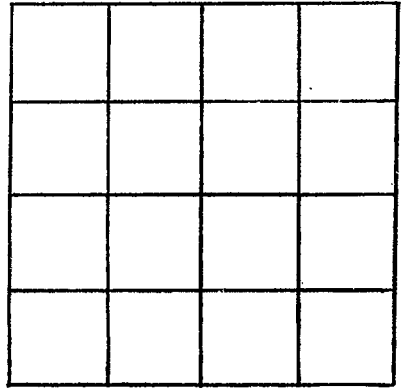

SECTION _____

Please indicate well location X.

ADDITIONAL INFORMATION

If more than one screen,
show locations of each on sketch.