

MISSISSIPPI DEPARTMENT OF NATURAL RESOURCES

Bureau of Land and Water Resources

Southport Mall

P.O. Box 10631

Jackson, Mississippi 39209

WATER WELL DRILLERS LOG

Newton  
L  
2664

7-19-83 19 McDonald + Hill Newton  
date well completed firm name county well located

LANDOWNER:	description of formations encountered	from	to
<u>Bealdy Kanayrak</u>	<u>clay</u>	<u>0</u>	<u>20</u>
<u>Rt #1 Hickory</u> (mailing address)	<u>clay st sand</u>	<u>20</u>	<u>45</u>
WELL LOCATION:	<u>sand &amp; shale</u>	<u>45</u>	<u>70</u>
sec. <u>13</u> T. <u>6</u> N. R. <u>12</u> E. S. W.	<u>shale</u>	<u>70</u>	<u>106</u>
<u>4</u> miles <u>N</u> of <u>Hickory</u> (distance) (direction) (nearest town)	<u>Rock &amp; shale</u>	<u>106</u>	<u>140</u>
WELL PURPOSE: <u>home</u> (home, irrigation, municipal, industrial)	<u>green sand</u>	<u>140</u>	<u>150</u>
WELL COMPLETION DATA:	<u>shale &amp; Rock.</u>	<u>150</u>	<u>265</u>
(1) diameter (inches) <u>4"</u>	<u>shale st sand</u>	<u>265</u>	<u>280</u>
(2) total depth (feet) <u>300'</u>	<u>sand</u>	<u>280</u>	<u>300</u>
(3) static water level (feet) <u>70'</u> below top of ground.			
(4) casing <u>PVC</u> , <u>102'</u> (material) (depth)			
<u>4"</u> (size) if telescope see back.			
(5) screen (length) (depth to top)			
(size) (material)			
(6) pump <u>1/2</u> <u>76.0 m</u> (HP) (yield gpm)			
(type power)			
(7) electric log (yes or no)			
(organization running log)			
(8) how well bottom plugged <u>open</u>			

MISSISSIPPI DEPARTMENT OF NATURAL RESOURCES  
BUREAU OF LAND & WATER RESOURCES


JUL 25 1983

RECEIVED

DRILLERS REMARKS:

If well telescopes please sketch and show depths.

GROUND LEVEL

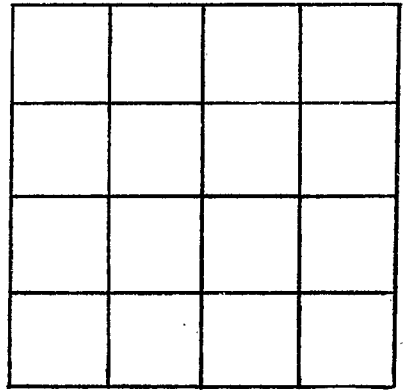

SECTION \_\_\_\_\_

Please indicate well location X.

ADDITIONAL INFORMATION

If more than one screen, show locations of each on sketch.