

MISSISSIPPI DEPARTMENT OF NATURAL RESOURCES
 Bureau of Land and Water Resources
 Southport Mall
 P.O. Box 10631
 Jackson, Mississippi 39209
WATER WELL DRILLERS LOG

Newton
L
2069

9-3-84
 date well completed

McDonald & Will
 firm name

Newton
 county well located


LANDOWNER:	description of formations encountered	from	to
<u>Jim Handford</u>			
<u>P.O. Box 142 Decatur</u> (mailing address)	<u>shale</u>	<u>10</u>	<u>55</u>
WELL LOCATION:	<u>sand</u>	<u>55</u>	<u>90</u>
sec. <u>15</u> T <u>6</u> N R <u>12</u> E	<u>sandy shale</u>	<u>90</u>	<u>110</u>
<u>5</u> miles <u>N</u> of <u>Nicks</u>	<u>shale</u>	<u>110</u>	<u>137</u>
(distance) (direction) (nearest town)	<u>rocks & shells</u>	<u>137</u>	<u>165</u>
WELL PURPOSE: <u>home</u>	<u>green sand & sandy</u>	<u>165</u>	<u>185</u>
(home, irrigation, municipal, industrial)	<u>shale</u>		
WELL COMPLETION DATA:	<u>rock & shale</u>	<u>185</u>	<u>240</u>
(1) diameter (inches) <u>4"</u>	<u>not sand</u>		
(2) total depth (feet) <u>240'</u>			
(3) static water level (feet) <u>87'</u> below top of ground.			
(4) casing <u>PVC</u> <u>132'</u> (material) (depth)			
<u>4"</u> (size) if telescope see back.			
(5) screen _____ (length) (depth to top)			
(size) (material)			
(6) pump <u>3/4</u> <u>800</u> (HP) (yield gpm)			
<u>K</u> (type power)			
(7) electric log _____ (yes or no)			
(organization running log)			
(8) how well bottom plugged <u>open</u>			
DRILLERS REMARKS:			

DEPT. OF NATURAL RESOURCES
 BUREAU OF LAND & WATER RESOURCES

SEP - 7 1984
RECEIVED

If well telescopes please sketch and show depths.

GROUND LEVEL

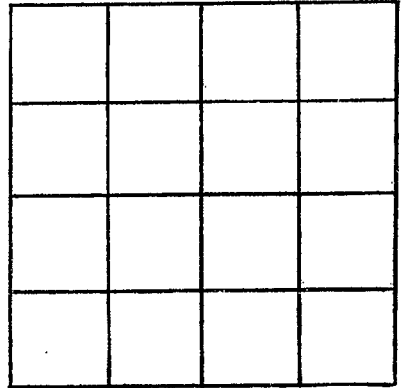

SECTION _____

Please indicate well location X.

ADDITIONAL INFORMATION

If more than one screen,
show locations of each on sketch.