

MISSISSIPPI DEPARTMENT OF NATURAL RESOURCES

Bureau of Land and Water Resources

Southport Mall

P.O. Box 10631

Jackson, Mississippi 39209

WATER WELL DRILLERS LOG

Newton  
L  
2070

9-18-84 19 McDonald's Well Newton  
 date well completed firm name county well located

LANDOWNER:  
Edward Shoemaker  
RT # 1 Box 148 Hickory  
 (mailing address)

description of formations encountered	from	to
<u>clay</u>	<u>0</u>	<u>20</u>
<u>clay &amp; sand</u>	<u>20</u>	<u>1/5</u>
<u>shale &amp; sand</u>	<u>1/5</u>	<u>60</u>
<u>sand</u>	<u>60</u>	<u>95</u>

WELL LOCATION:  
 sec. 10 T. 6 N. R. 12 E.  
 S. W.  
6 miles N of Hickory  
 (distance) (direction) (nearest town)

WELL PURPOSE: home  
 (home, irrigation, municipal, industrial)

WELL COMPLETION DATA:

(1) diameter (inches) 4"

(2) total depth (feet) 95'

(3) static water level (feet) 30' below above top of ground.

(4) casing PVC, 90'  
 (material) (depth)  
2" if telescope see back.  
 (size)

(5) screen 5', 90' to 95'  
 (length) (depth to top)  
2", PVC  
 (size) (material)

(6) pump 1, 69 gpm  
 (HP) (y'eld gpm)  
F  
 (type power)

(7) electric log             
 (yes or no)  
            
 (organization running log)

(8) how well bottom plugged variable

DEPT. OF NATURAL RESOURCES  
 BUREAU OF LAND & WATER RESOURCES


SEP 24 1984

RECEIVED

DRILLERS REMARKS:

If well telescopes please sketch and show depths.

GROUND LEVEL

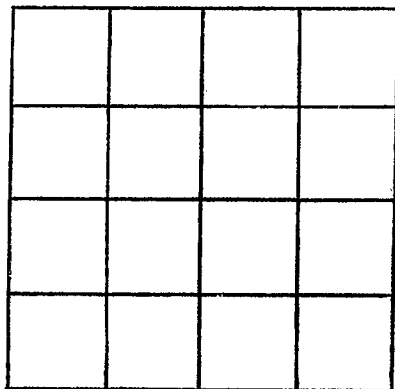

SECTION \_\_\_\_\_

Please indicate well location X.

ADDITIONAL INFORMATION

If more than one screen,  
show locations of each on sketch.