

MISSISSIPPI DEPARTMENT OF NATURAL RESOURCES

Bureau of Land and Water Resources

Southport Mall

P.O. Box 10631

Jackson, Mississippi 39209

WATER WELL DRILLERS LOG

Newton
L
2071

9-19-84 19 McDonald & Well Newton
 date well completed firm name county well located

LANDOWNER:
James Ester
Rt # 1 Hickory
 (mailing address)

WELL LOCATION:
 sec. 15 T. 4 N. R. 2 E.
5 miles N of Hickory
 (distance) (direction) (nearest town)

WELL PURPOSE: hom.
 (home, irrigation, municipal, industrial)

WELL COMPLETION DATA:

(1) diameter (inches) 4"

(2) total depth (feet) 330'

(3) static water level (feet) 80' below top of ground.

(4) casing PVC 130'
 (material) (depth)
4" If telescope see back.
 (size)

(5) screen _____
 (length) (depth to top)
 (size) _____ (material)

(6) pump 1/2 800m
 (HP) (y'el'd' gpm)
K
 (type power)

(7) electric log _____
 (yes or no)

 (organization running log)

(8) how well bottom plugged Open

description of formations encountered	from	to
clay	0	20
clay st sand	20	45
shale & sand	48	85
shale	85	135
Rock & shell	135	170
green sand & sandy shale	170	185
shale & ROCK	195	245
shale st. sand	245	305
white sand	305	320


DEPT. OF NATURAL RESOURCES
 BUREAU OF LAND & WATER RESOURCES

SEP 24 1984
 RECEIVED

DRILLERS REMARKS:
set pump at 120 ft

If well telescopes please sketch and show depths.

GROUND LEVEL

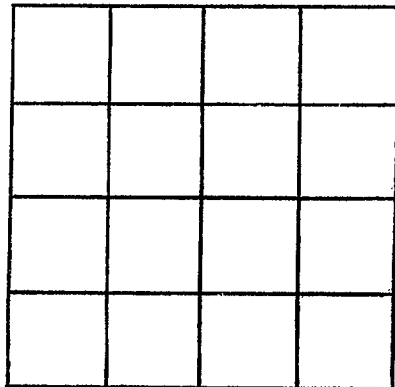

SECTION _____

Please indicate well location X.

ADDITIONAL INFORMATION

If more than one screen,
show locations of each on sketch.