

MISSISSIPPI DEPARTMENT OF NATURAL RESOURCES

Bureau of Land and Water Resources

Southport Mall

P.O. Box 10631

Jackson, Mississippi 39209

WATER WELL DRILLERS LOG

NEWTON
L 2072
3-19-85

3 19 1985 McDonald + Hillman Newton
 date well completed firm name county well located

LANDOWNER: Bobby Butler
Rt 1 Box 85A
Hickory, MS
 (mailing address)

description of formations encountered	from	to
Clay	0	10
Coarse sand	10	78
Shale	78	120
Green sand st Rab	120	155
Rock + shale	155	270
sandy	270	282
ST COARSE SAND	282	300

WELL LOCATION:
 sec. 3 T. 6 N. R. 12 E
4 miles East of Newton
 (distance) (direction) (nearest town)

WELL PURPOSE: none
 (home, irrigation, municipal, industrial)

- WELL COMPLETION DATA:
- (1) diameter (inches) 4
 - (2) total depth (feet) 300
 - (3) static water level (feet) 70 below above top of ground.
 - (4) casing 4" PVC 107'
 (material) (depth)
 (size) If telescope see back.
 - (5) screen _____
 (length) (depth to top)
 (size) (material)
 - (6) pump 10
 (HP) (yield gpm)
 (type power)
 - (7) electric log _____
 (yes or no)
 (organization running log)
 - (8) how well bottom plugged opened


RECEIVED
 MAR 26 1985

Department of Natural Resources
 Bureau of Land & Water Resources

DRILLERS REMARKS:

If well telescopes please sketch and show depths.

GROUND LEVEL

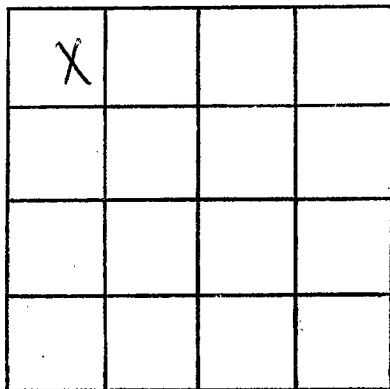

SECTION 36

Please indicate well location X.

ADDITIONAL INFORMATION

If more than one screen, show locations of each on sketch.