

Newton
L 2073
7-18-85

MISSISSIPPI DEPARTMENT OF NATURAL RESOURCES
Bureau of Land and Water Resources
Southport Mall
P.O. Box 10631
Jackson, Mississippi 39209
WATER WELL DRILLERS LOG

L

7-18-85 date well completed
McDONALD + HILL firm name
NEWTON county well located

LANDOWNER:	description of formations encountered	from	to
GERALD MATLOCK	CLAY SAND	0	16
R#1 Hickory MS (mailing address)	SAND	16	44
	SHALE	44	90
	SHELLS + SAND + ROCK	90	124
	SHALE ST ROCK	124	260
	SAND	260	280
WELL LOCATION: sec. 12 T. 6 N. R. 12 E 4 miles NE of Hickory (distance) (direction) (nearest town)			
WELL PURPOSE: HOME (home, irrigation, municipal, industrial)			
WELL COMPLETION DATA:			
(1) diameter (inches) 4"			
(2) total depth (feet) 280			
(3) static water level (feet) 86' below top of ground.			
(4) casing PVC, 85' (depth) 4" (size) if telescope see back.			
(5) screen (length) (depth to top) (size) (material)			
(6) pump 5-8 GPM (HP) (yield gpm) (type power)			
(7) electric log (yes or no) (organization running log)			
(8) how well bottom plugged OPEN			

RECEIVED
JUL 23 1985


Department of Natural Resources
Bureau of Land & Water Resources

cleaned to 126 ft

DRILLERS REMARKS:
SET PUMP 120'

If well telescopes please sketch and show depths.

GROUND LEVEL

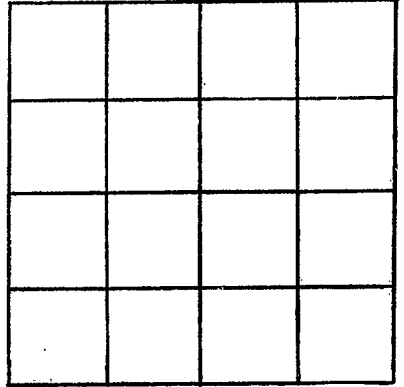

SECTION _____

Please indicate well location X.

ADDITIONAL INFORMATION

If more than one screen, show locations of each on sketch.