

MISSISSIPPI DEPARTMENT OF NATURAL RESOURCES

Bureau of Land and Water Resources

Southport Mall

P.O. Box 10631

Jackson, Mississippi 39209

WATER WELL DRILLERS LOG

NEWTON
L
2075

4.29.86 date well completed McDonald HILLI firm name NEWTON county well located

LANDOWNER:	description of formations encountered	from	to
JIMMY HALL Box 233 Hickory MS (mailing address)			
WELL LOCATION: sec. 9 T 6 N R 12 E 3 1/2 miles NORTH Hickory (distance) (direction) (nearest town)	SHALE	16	30
	SAND	30	65
	SHALE	65	125
	SAND	125	155
	SHALE	155	206
	ROCK ST SHELLS	206	228
	GREEN SAND	228	250
	SANDS ST SHALE	250	280

WELL PURPOSE: HOME
(home, irrigation, municipal, industrial)

WELL COMPLETION DATA:

(1) diameter (inches) 4 1/2

(2) total depth (feet) 280

(3) static water level (feet) 130 below top of ground.


(4) casing PVC 188 (material) (depth)
4 1/2 (size) If telescope see back.

(5) screen (length) (depth to top)
(size) (material)

(6) pump (HP) (yield gpm)
(type power)

(7) electric log (yes or no)
(organization running log)


(8) how well bottom plugged OPEN

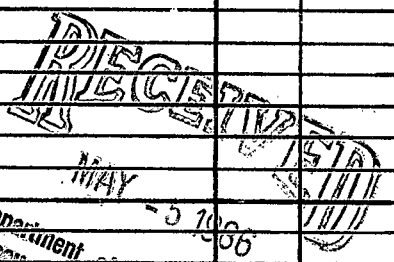

DRILLERS REMARKS:

If well telescopes please sketch and show depths.

GROUND LEVEL

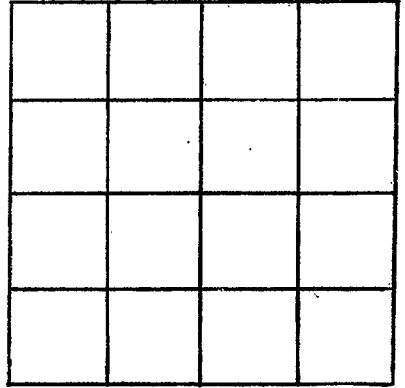

SECTION _____

Please indicate well location X.

ADDITIONAL INFORMATION

If more than one screen,
show locations of each on sketch.