

MISSISSIPPI DEPARTMENT OF NATURAL RESOURCES

Bureau of Land and Water Resources

Southport Mall

P.O. Box 10631

Jackson, Mississippi 39209

WATER WELL DRILLERS LOG

Newton
L
2076

1-23-86 19 McDONALD + H&I NEWTON
 date well completed firm name county well located

LANDOWNER: JIMMY CATES
R#1 Hickory MS
 (mailing address)
 WELL LOCATION:
 sec. 12 T. 6 N. R. 12 E
 S W
4 miles NORTH of Hickory
 (distance) (direction) (nearest town)

description of formations encountered	from	to
<u>CLAY</u>	<u>0</u>	<u>14</u>
<u>SHALE</u>	<u>14</u>	<u>70</u>
<u>SAND + SHELLS + ROCK</u>	<u>70</u>	<u>110</u>
<u>SHALE + ROCK</u>	<u>110</u>	<u>220</u>
<u>COURSE SAND</u>	<u>220</u>	<u>240</u>

WELL PURPOSE: HOME
 (home, irrigation, municipal, industrial)


- WELL COMPLETION DATA:
- (1) diameter (inches) 4"
 - (2) total depth (feet) 240'
 - (3) static water level (feet) 80' below top of ground.
 - (4) casing PVC, 144'
 (material) (depth)
4"
 (size) if telescope see back.
 - (5) screen _____
 (length) (depth to top)
 (size) (material)
 - (6) pump _____
 (HP) (yield gpm)
 (type power)
 - (7) electric log _____
 (yes or no)
 (organization running log)
 - (8) how well bottom plugged OPEN

RECEIVED
 FEB - 7 1986
 Department of Natural Resources
 Bureau of Land & Water Resources

DRILLERS REMARKS:

If well telescopes please sketch and show depths.

GROUND LEVEL

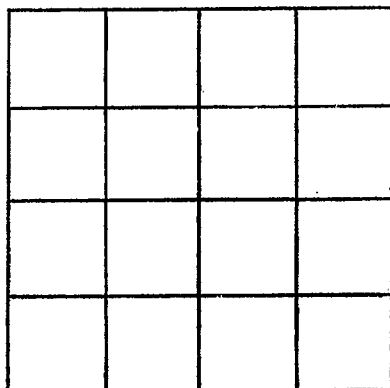

SECTION _____

Please indicate well location X.

ADDITIONAL INFORMATION

If more than one screen,
show locations of each on sketch.