

MISSISSIPPI DEPARTMENT OF NATURAL RESOURCES

Bureau of Land and Water Resources

Southport Mall

P.O. Box 10631

Jackson, Mississippi 39209

WATER WELL DRILLERS LOG

Newton
L
2077

5.2.86 19 McDONALD HILL NEWTON
 date well completed firm name county well located

LANDOWNER:
CHARLES HARRISON
Hickory MS
 (mailing address)

description of formations encountered	from	to
CLAY	0	12
LiGHITE	12	16
SAND	16	94
SOFT SANDS	94	106
SHALE	106	135
SANDS STRock	135	160
SAND STRock	160	200

WELL LOCATION:
 sec. 25 T 6 N R 12 E
 S W
1 miles NORTH of Hickory
 (distance) (direction) (nearest town)

WELL PURPOSE: HOME
 (home, irrigation, municipal, industrial)

WELL COMPLETION DATA:

(1) diameter (inches) 4"

(2) total depth (feet) 200'

(3) static water level (feet) 160' below above top of ground.

(4) casing PVC 120
 (material) (depth)
4"
 (size) if telescope see back.


(5) screen _____
 (length) (depth to top)
 (size) (material)

(6) pump _____
 (HP) (yield gpm)
 (type power)

(7) electric log _____
 (yes or no)
 (organization running log)

(8) how well bottom plugged OPEN


DRILLERS REMARKS:

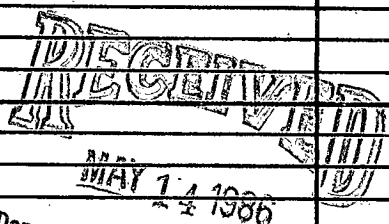

Department of Natural Resources
 Bureau of Land and Water Resources

If well telescopes please sketch and show depths.

GROUND LEVEL

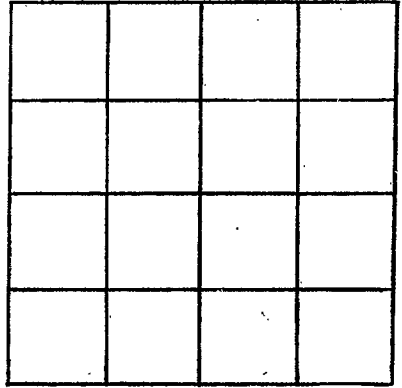

SECTION _____

Please indicate well location X.

ADDITIONAL INFORMATION

If more than one screen,
show locations of each on sketch.