

Bureau of Land and Water Resources
 Southport Mall
 P.O. Box 10631
 Jackson, Mississippi 39209
WATER WELL DRILLERS LOG

NEWTON
L
2078

7-15-86 19 MCDONALD HILL NEWTON
 date well completed firm name county well located

LANDOWNER:
MARY HERRIS
Rt 1 NEWTON MS
 (mailing address)


description of formations encountered	from to	
<u>CLAY</u>	<u>0</u>	<u>20</u>
<u>FINE SAND</u>	<u>20</u>	<u>55</u>
<u>CLAY ST SAND</u>	<u>55</u>	<u>120</u>
<u>COURSE SAND</u>	<u>120</u>	<u>130</u>

WELL LOCATION:
 sec 7 T 6 N R 12 E
3 miles NORTH of NEWTON
 (distance) (direction) (nearest town)

WELL PURPOSE: HOME
 (home, irrigation, municipal, industrial)

WELL COMPLETION DATA:

- diameter (inches) 2"
- total depth (feet) 130'
- static water level (feet) 8' below top of ground.
- casing PVC 120'
 (material) (depth)
2" if telescope see back.
 (size)
- screen 10' 120'
 (length) (depth to top)
2" PVC
 (size) (material)
- pump _____
 (HP) (yield gpm)
 (type power)
- electric log _____
 (yes or no)
 (organization running log)
- how well bottom plugged VALUE

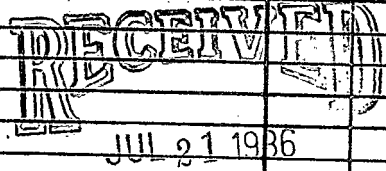

Department of Natural Resources
 Bureau of Land & Water Resources

DRILLERS REMARKS:

Handwritten notes or bleed-through from the reverse side of the page, appearing as faint, illegible markings.