


Newton  
L 2079

MISSISSIPPI DEPARTMENT OF NATURAL RESOURCES  
Bureau of Land and Water Resources  
Southport Mall  
P.O. Box 10631  
Jackson, Mississippi 39209  
WATER WELL DRILLERS LOG

9/1/86 19 TERRY DRUG Newton  
date well completed firm name county well located

LANDOWNER:	description of formations encountered	from	to
Johnson Trailer Sales Heckory, Miss. (mailing address)			
WELL LOCATION:	yellow clay	0	20
sec. 23 T-6 N R-12 E	sandy	20	50
S W	clay & rock	50	150
1 miles N of Heckory	sandy	150	180
(distance) (direction) (nearest town)	clay	180	300
WELL PURPOSE: Trailer Sales	sandy	300	380
(home, irrigation, municipal, industrial)			
WELL COMPLETION DATA:			
(1) diameter (inches) 4"			
(2) total depth (feet) 380			
(3) static water level (feet) 80 below top of ground.			
(4) casing PVC 200 (material), (depth)			
(size) if telescope see back.			
(5) screen NO (length), (depth to top)			
(size) (material)			
(6) pump 1/2 5-6 (HP) (yield gpm)			
sub (type power)			
(7) electric log (yes or no)			
(organization running log)			
(8) how well bottom plugged open			

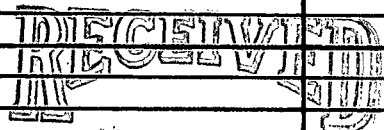


SEP 19 1986

Department of Natural Resources  
Bureau of Land & Water Resources

DRILLERS REMARKS:

If well telescopes please  
sketch and show depths.

GROUND LEVEL

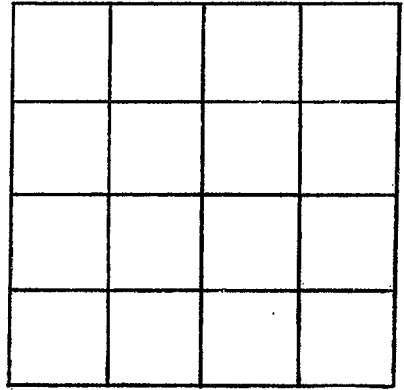

SECTION \_\_\_\_\_

Please indicate well location X.

ADDITIONAL INFORMATION

If more than one screen,  
show locations of each on sketch.