

MISSISSIPPI DEPARTMENT OF NATURAL RESOURCES

Bureau of Land and Water Resources

COUNTY WELL LOCATED NEWTON	
WELL NUMBER L 2085	CODED
DATE WELL COMPLETED 6-7-85	

PERMIT NUMBER
NAME OF DRILLING FIRM McDONALD + HILL
MDN MS

P.O. Box 10631
Jackson, Mississippi 39209
WATER WELL DRILLERS LOG

NAME & MAILING ADDRESS OF LANDOWNER WILLIE LEDLOW			
Hickory MS			
WELL LOCATION:	SEC 8	TOWNSHIP N 6 S	RANGE 12 E
DISTANCE 4 Miles	DIRECTION NW	NEAREST TOWN Hickory	
OTHER LANDMARK			
WELL PURPOSE (Home Irrigation, Municipal, Industrial, Fish Pond, etc) <input checked="" type="radio"/> Home Irrigation			

PUMP DATA		
PUMP TYPE (Circle One): <input checked="" type="radio"/> Submersible Turbine Jet Flowing Well, Other (Describe) _____		
POWER TYPE (Circle One): <input checked="" type="radio"/> Electric Tractor Diesel Gasoline Butane, Other (Describe) _____		
Pump Capacity (GPM) 5	No. of Stages 9	Setting Depth 180 FT.
PUMP TEST		
Well yielded _____ GPM with a drawdown of _____ ft. after _____ hours of pumping		


WELL DATA		
Well Depth 260	Casing Diameter (In.) 4"	Casing Length (Ft.) 195'
Type of Casing pvc	Hole Depth 260	Depth to Static Water Level 135'
-TYPE OF COMPLETION: (Circle One or More): Gravel Packed, Underreamed, Telescoped, Natural Development, <input checked="" type="radio"/> Open Hole, Other (Describe) _____		
Top of Lap Pipe or Reduction in Casing FEET IF TELESCOPED OR MORE THAN ONE SCREEN: USE BACK PAGE		

LOG DATA	
TYPE OF LOG RUN (Circle One): No Log Run, Electric, Gamma Ray, Density, Sonic, Neutron, Other (Describe) _____	
Name of Organization Running Log	

SCREEN DATA		
Diameter - Inches	Length - Feet	Slot Size - Inches
Screen Type		Depth to Bottom - Feet


GEOLOGIC DATA (Office Use Only)			
Surface Elev.	Geologic Unit	Unit Thickness	Depth to Top
Subs. SWL	Date	Analysis	Aquifer Test
Driller's Remarks			

DESCRIPTION OF FORMATIONS ENCOUNTERED	FROM	TO
CLAY	0	20
SAND ST CLAY	20	150
SOFT CLAY	150	170
CLAY	170	208
ROCK ST SHELLS	208	225
GREEN SAND	225	245
SANDY	245	260

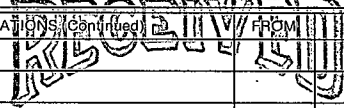 JUL 07 1989 Department of Natural Resources Bureau of Land & Water Resources	FORMATIONS (Continued) FROM TO IF MORE SPACE IS NEEDED, USE BACK
---	---

If well telescopes please sketch and show depths.

GROUND LEVEL

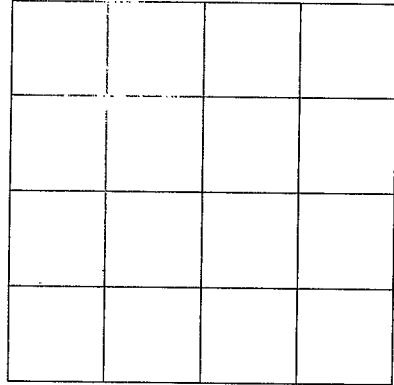

SECTION _____
Please indicate well location X.

ADDITIONAL INFORMATION

If more than one screen,
show location of each on sketch.