

Newton
M
5-67

MISSISSIPPI
BOARD OF WATER COMMISSIONERS
416 North State Street
Jackson, Mississippi 39201

WATER WELL DRILLERS LOG

5-11-67 19 McDonald Hill NEWTON
date well completed firm name county well located

LANDOWNER: LEE CROFT

HICKORY MISS

(mailing address)

description of formations encountered

from to

CLAY	0	8
SAND	8	14
SHALE	14	26
PINK SAND S. SHALE	26	33
SANDY ST SHALE	33	120
SHALE ST SHALE	120	160
SHALE	160	180
PINK SAND	180	205
SAND 10-12	205	220

WELL LOCATION:


sec 31 T 6 N R 13 E
S W
3 miles EAST of HICKORY
(distance) (direction) (nearest town)

WELL PURPOSE: HOME
(home, irrigation, municipal, industrial)

WELL COMPLETION DATA:


- (1) diameter (inches) 3 3/8 TEST HOLE
- (2) total depth (feet) 220'
- (3) static water level (feet) 12 below above top of ground.
- (4) casing GALL, 215'
(material) (depth)
- N/S If telescope see back.
(size)
- (5) screen 6', 214
(length) (depth to top)
- 2", BRASS
(size) (material)
- (6) pump 1/2, 6
(HP) (yield gpm)
- 115
(type power)
- (7) electric log NO
(yes or no)
- NO
(organization running log)
- (8) how well bottom plugged VALVE

DRILLERS REMARKS:

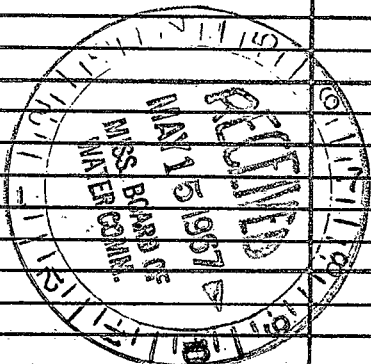

If well telescopes please sketch and show depths.

GROUND LEVEL

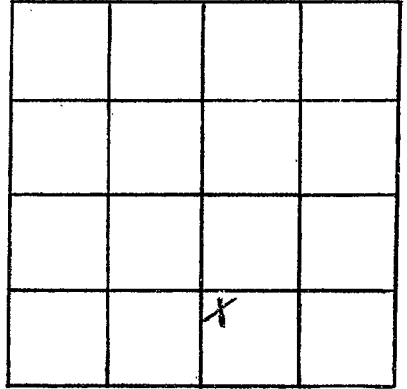

SECTION _____

Please indicate well location X.

ADDITIONAL INFORMATION

If more than one screen,
show locations of each on sketch.