

NEWTON MISSISSIPPI
M/T

MISSISSIPPI

WATER COMMISSIONERS

P

WATER WELL DRILLERS LOG

M

12-21-61

Date: 12-21, 1961, Driller: McDONALD HILL County: NEWTON

(Name)

(1) Owner of Land: CG POUGH
(Name)

Chunky
(Address)

(2) Location: 1/4, 1/4, Sec. 21 T6N R13E

3 miles W.N.W., of Chunky
(distance) (direction) (Nearest Town)

(3) Topography: X
(Hilly) (Flat) (Level)

(4) Purpose of Well: DOMESTIC
(Domestic Irrigation
Municipal, Industrial, Other)

Description & Color of Materials Sand, Clay, Red Clay, Shell, etc.	Thick- ness Feet	Depth Feet
<u>CLAY</u>	<u>0</u>	<u>20</u>
<u>SAND-CLAY</u>	<u>20</u>	<u>32</u>
<u>SHALE</u>	<u>32</u>	<u>90</u>
<u>SHALE ST ROCK</u>	<u>90</u>	<u>160</u>
<u>SAND</u>	<u>160</u>	<u>190</u>

Information upon completion of well:

(1) Diameter 4" inches.

(2) Total Depth 190' feet.

(3) Water Level 36' feet below top of ground.

(4) Cased to 43', Size 4"


(5) Screen: Size _____, Length _____

(6) Were any formations sealed against pollution?
_____ yes, _____ no.

If YES depth of formation _____

Why _____

Drillers Remarks: _____

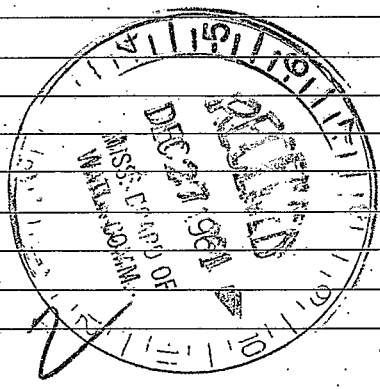

(Use Back Side)

Well No.

1944

1945

1946

1972