

M 2

5-23-62

WATER WELL DRILLERS LOG

Date: 5-23, 1962, Driller: Mr. Donald Hill County Newton

(Name)

(1) Owner of Land: Gerald Chavira (Name) Chunky, miss (Address)

(2) Location: 1/4, 1/4, Sec. 34 T6R18, 1 miles West of Chunky (distance), (direction), (Nearest Town)

(3) Topography: (Hilly) (Flat) (Level)

(4) Purpose of Well: Domestic (Domestic Irrigation, Municipal, Industrial, Other)

Table with 3 columns: Description & Color of Materials (Sand, Clay, Red Clay, Shell, etc.), Thickness Feet, Depth Feet. Entries include Sand, Clay, Soft Shale, Rock & Shale, Sand #12.

Information upon completion of well:


- (1) Diameter 4 inches.
(2) Total Depth 180 feet.
(3) Water Level 31 feet below top of ground.
(4) Cased to 63, Size
(5) Screen: Size NONE Length
(6) Were any formations sealed against pollution?

yes, no.

If YES depth of formation

Why

Drillers Remarks:

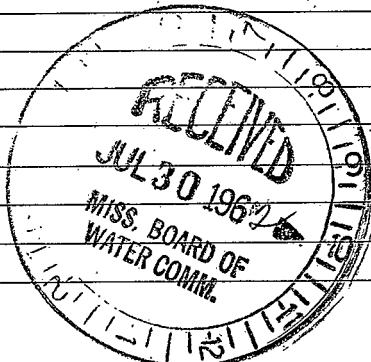

(Use Back Side)

Well No.

PHYTOCHLOROPHYLLS

Main body of text containing multiple paragraphs of scientific text, likely describing the properties and functions of phytyl chlorophylls.

- A list of references or citations, including names and dates (e.g., 1975, 1976).