

WATER WELL DRILLERS LOG

M3

6-28-62

Date: 6-28, 1962, Driller: U. L. Shelch County Newton
(Name)

(1) Owner of Land: Billy Munn
(Name)
Hickory Miss
(Address)

(2) Location: SW 1/4, SE 1/4, Sec. 31 T6 R13
1 miles S. East, of Hickory
(distance) (direction) (Nearest Town)

(3) Topography: ✓
(Hilly) (Flat) (Level)

(4) Purpose of Well: Domestic
(Domestic Irrigation
Municipal, Industrial, Other)

Description & Color of Materials Sand, Clay, Red Clay, Shell, etc.	Thick- ness Feet	Depth Feet
clay	8	0-8
Sand	34	8-42
Black	33	42-75
Blue + Rocky	170	75-245
Sand	21	245-266
		266

Information upon completion of well:

(1) Diameter 2" inches.

(2) Total Depth 266 feet.

(3) Water Level 10' feet below top of ground.

(4) Cased to 63, Size 2"


(5) Screen: Size None, Length _____

(6) Were any formations sealed against pollution?
✓ yes, _____ no.

If YES depth of formation 42'

Why Top sand

Drillers Remarks: _____

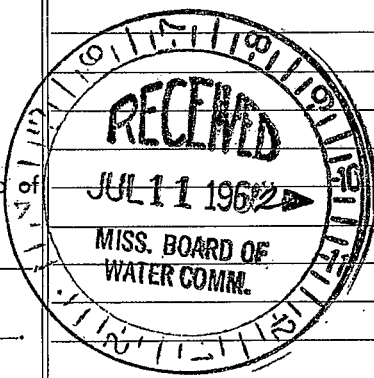

3

(Use Back Side)

42
Well No.

