

MS  
6-16-65

WATER WELL DRILLERS LOG

Date: 6-16, 1965, Driller: McDonald & Hill, Inc. County: Audubon

(Name)

(1) Owner of Land: Eugene Cooley  
 (Name)  
 Rt #1 Hickory Miss  
 (Address) N

(2) Location: 1/4, 1/4, Sec. 5 T. 6 R. 13, N  
 5 miles north W. of Chunky  
 (distance) (direction) (Nearest Town)

(3) Topography:  (Hilly)  (Flat)  (Level)

(4) Purpose of Well: Domestic  
 (Domestic Irrigation  
 Municipal, Industrial, Other)

Description & Color of Materials Sand, Clay, Red Clay, Shell, etc.	Thick- ness Feet	Depth Feet
Clay & sand	0	22
lime rock & shale	22	55
Soft sandy shale	55	65
Hard -	65	110
lime rock	110	182
Soft shale	182	185
Sandy	185	188
Soft shale	188	200
C sand	200	210
M shale	210	220

Information upon completion of well:

(1) Diameter 4 inches.

(2) Total Depth 220 feet.

(3) Water Level 80 feet below top of ground.

(4) Cased to 23 ft, Size 4"


(5) Screen: Size \_\_\_\_\_, Length \_\_\_\_\_.

(6) Were any formations sealed against pollution?  
 yes,  no.

If YES depth of formation \_\_\_\_\_

Why \_\_\_\_\_

Drillers Remarks: \_\_\_\_\_

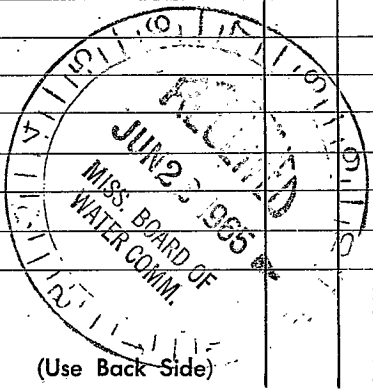

(Use Back Side)

Well No.

