

WATER WELL DRILLERS LOG

M7
5-21-63

Date: 05-21, 1963, Driller: McDaniel & Sons Newton
(Name)


- (1) Owner of Land: Frank Jackson
(Name)
(Address)
- (2) Location: 1/4, 1/4, Sec. 11 T6 R13
3 miles North, of Chancellor
(distance) (direction) (Nearest Town)
- (3) Topography: Hilly
(Hilly) (Flat) (Level)
- (4) Purpose of Well: Domestic
(Domestic Irrigation
Municipal, Industrial, Other)

Description & Color of Materials Sand, Clay, Red Clay, Shell, etc.	Thick- ness Feet	Depth Feet
Clay	0	0
Silt	8	35
Shale	35	60
Thin shale & lime	60	75
Silt	75	92
Shale w/ lime strip	92	160
Thin shale	100	188
Silt shale	188	205
Silt	205	228

Information upon completion of well:

- (1) Diameter 3 1/4 inches.
- (2) Total Depth 228 feet.
- (3) Water Level 140 feet below top of ground.
- (4) Cased to 160, Size 4"
- (5) Screen: Size 2", Length 5'
- (6) Were any formations sealed against pollution?
_____ yes, _____ no.

If YES depth of formation _____
Why _____
Drillers Remarks: _____

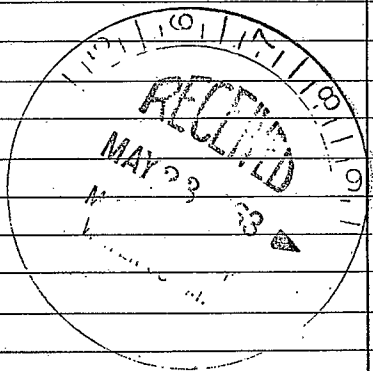

(Use Back Side)

Well No.

